

**NAME OF THE WORK**

**SURVEY PLAN AND ASSET MAPPING FOR HOSPITALS AND  
MEDICAL COLLEGES IN THE STATE OF TELANGANA**

**COMMUNITY HEALTH CENTRE AT HUSNABAD,  
KARIMNAGAR DISTRICT.**

**CLIENT :**

**TSMSIDC, 2<sup>ND</sup> FLOOR, DM & HS Campus,  
Sultan Bazar, Koti, Hyderabad-500029.**

**CONSULTANTS :**

**BHARGAV BUILDPRO TECHNOLOGIES PVT LTD.  
ARCHITECTURE / ENGINEERING / INTERIORS / PROJECT MANAGEMENT  
H.NO. : 3-6-213/2, I FLOOR, ST. NO. - 16, HIMAYATNAGAR  
HYDERABAD- 500029. PH - 040-23220974,  
FAX : 040-23220973  
EMAIL : bhargavassociateshyderabad@gmail.com**

**COMMUNITY HEALTH CENTRE AT HUSNABAD,  
KARIMNAGAR DISTRICT.**

<b>EXTENT AREA</b>	<b>: 3.802 ACRES.</b>
<b>BUILT-UP AREA</b>	
<b>HOSPITAL MAIN BLOCK</b>	<b>: 14389.72 SQ.FTS / 1337.848 SQ. MTS.</b>
<b>RENUKA MANDAL COMMITTE</b>	<b>: 4679.87 SQ.FTS / 434.774 SQ. MTS.</b>
<b>MORTUARY</b>	<b>: 596.22 SQ.FTS / 55.390 SQ. MTS.</b>
<b>STAFF QUARTER</b>	<b>: 1110.20 SQ.FTS / 103.140 SQ. MTS.</b>
<b>LAUNDRY</b>	<b>: 157.00 SQ.FTS / 14.585 SQ. MTS.</b>
<b>NEW HOSPITAL BUILDING</b>	<b>: 13903.87 SQ.FTS /1291.711 SQ .MTS.</b>
<b>STAFF NURSE QUARTER</b>	<b>: 923.77 SQ.FTS /85.821 SQ .MTS.</b>
<b>TOTAL AREA</b>	<b>: 35760.65 SQ.FTS /3323.269 SQ. MTS.</b>
<b>AVILABLE AREA</b>	<b>: 130789.885 SQ.FTS, 14095.517 SQ.MTS.</b>

**TYPE OF BUILDING**

<b>HOSPITAL MAIN BLOCK</b>	<b>: LOAD BEARING STRUCTURE COVERED RCC ROOF SLAB</b>
<b>RENUKA MANDAL COMMITTE</b>	<b>: LOAD BEARING STRUCTURE COVERED RCC ROOF SLAB</b>
<b>MORTUARY</b>	<b>: LOAD BEARING STRUCTURE COVERED RCC ROOF SLAB</b>
<b>STAFF QUARTER</b>	<b>: LOAD BEARING STRUCTURE COVERED RCC ROOF SLAB</b>
<b>LAUNDRY</b>	<b>: LOAD BEARING STRUCTURE COVERED</b>

**RCC ROOF SLAB**

**NEW HOSPITAL BUILDING : COLUMN BEARING STRUCTURE COVERED  
RCC SLAB**

**HOSPITAL MAIN BLOCK : GROUND FLOOR.**

**YEAR OF CONSTRUCTION : 1980,2013.**





**1. Husnabad**



**2. Husnabad**



**3. Husnabad**



**4. Husnabad**





**5. Husnabad**



**6. Husnabad**






**7. Husnabad**



**8. Husnabad**

# HUSNABAD COMMUNITY HEALTH CENTER AS BUILT DRAWING

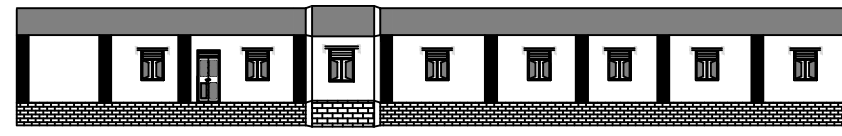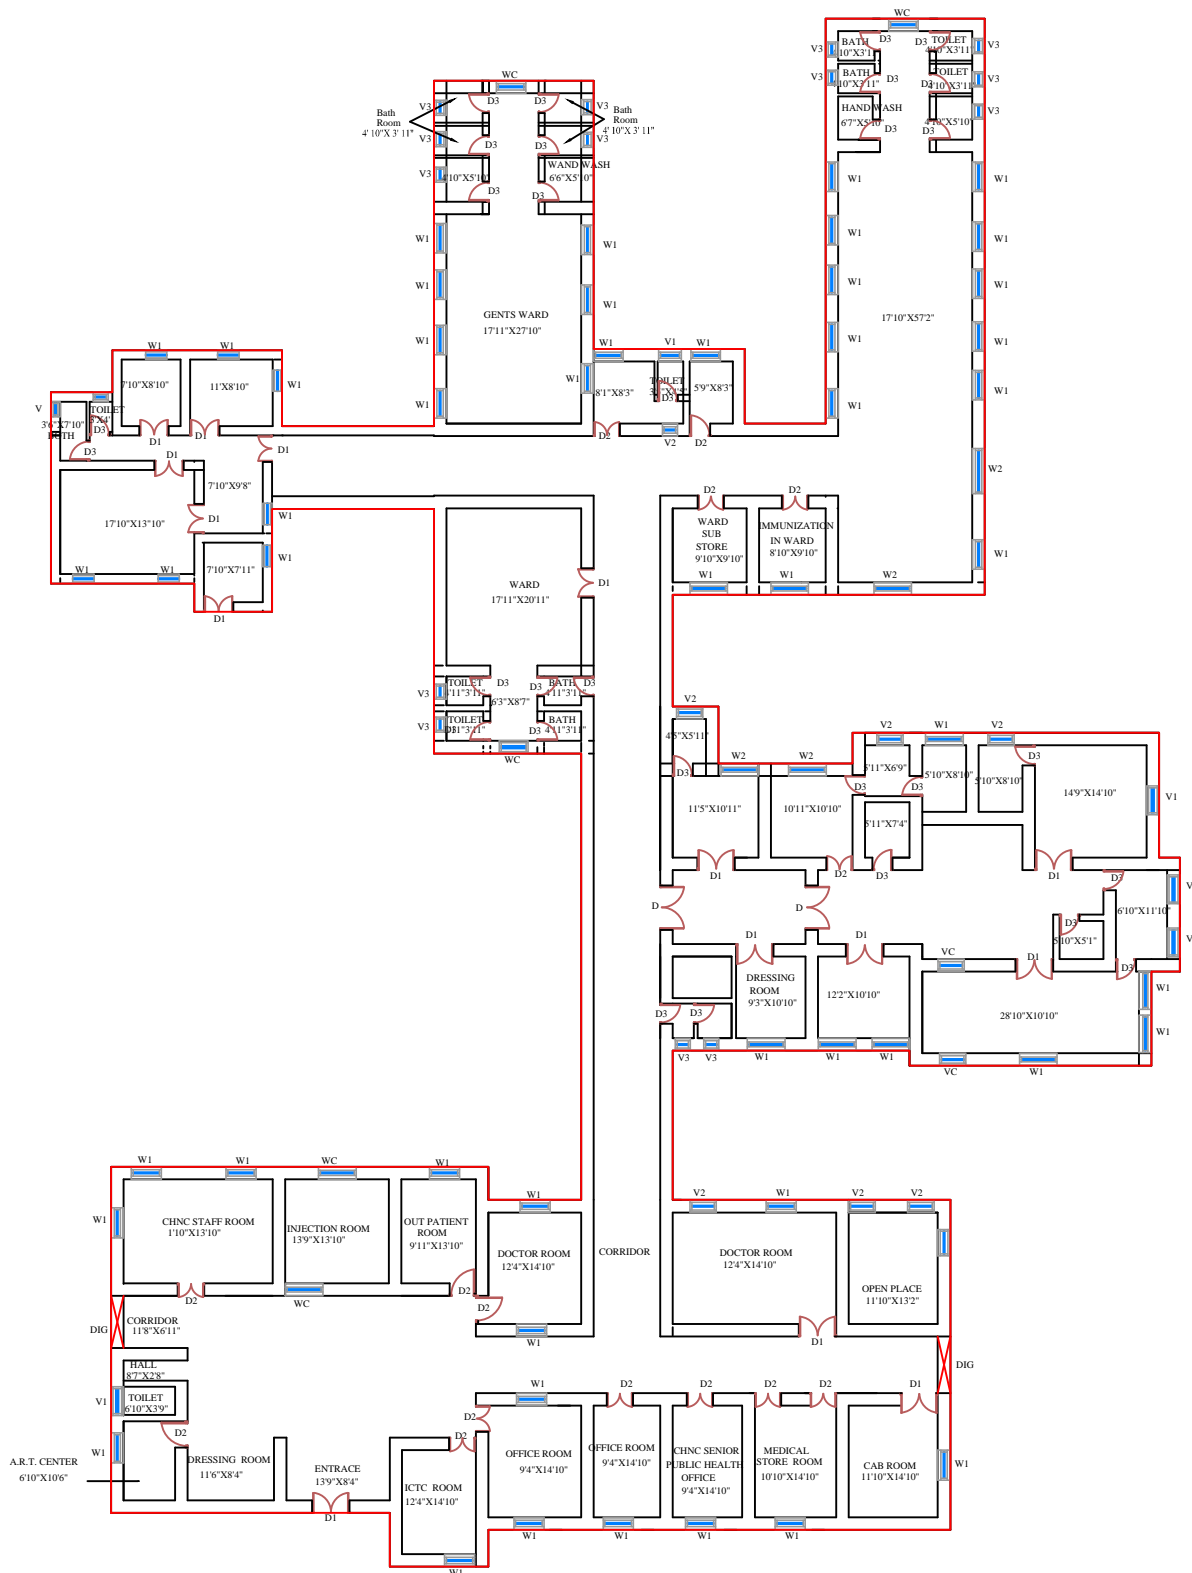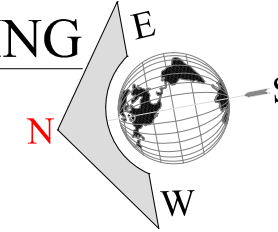

FRONT VIEW ELEVATION

SCALE : 1"=17'

**REFERENCE**

- D1..... 5' 11"
- D2..... 4' 11"
- D3..... 3' 6"
- D4..... 2' 9"
- WALL THICKNESS.....1' 3"
- W.....8' 11"
- W1.....6'
- W2.....3' 11"
- VENTILATOR..... 2'

**SITE :-**

COMMUNITY HEALTH CENTER  
HUSNABAD  
KARIMNAGAR DIST.  
TELANGANA STATE

**AREA DETAILS**

14389.72Sq. ft. 1336.848 Sq.mts

**DRAWING TITLE**

GROUND FLOOR &  
ELEVATION PLAN

SCALE = 1:1

**CLIENT**

TELANGANA STATE MEDICAL  
SERVICE INFRASTRUCTURE  
DEVELOPMENT CORPORATION

3 rd floor,DM&HS Campus,sultan bazaar,  
Koti, Hyderabad,T.S.-500095.  
040-24619123. Telefax : 040-24619120.

**CONSULTANT**






BHARGAV BUILDPRO TECHNOLOGIES PVT LTD  
ARCHITECTURE / ENGINEERING / INTERIORS / PROJECT MANAGEMENT  
H. NO - 3-6-213/2, 1 FLOOR, ST. NO. - 16, HIMAYATNAGAR,  
HYDERABAD 500029. PH : 040-23220974,  
FAX : 040-23220973

EMAIL : bhargavassociateshyderabad@gmail.com

YEAR OF CONSTRUCTION : 1980,2013.

# HUSNABAD COMMUNITY HEALTH CENTER AS BUILT DRAWING

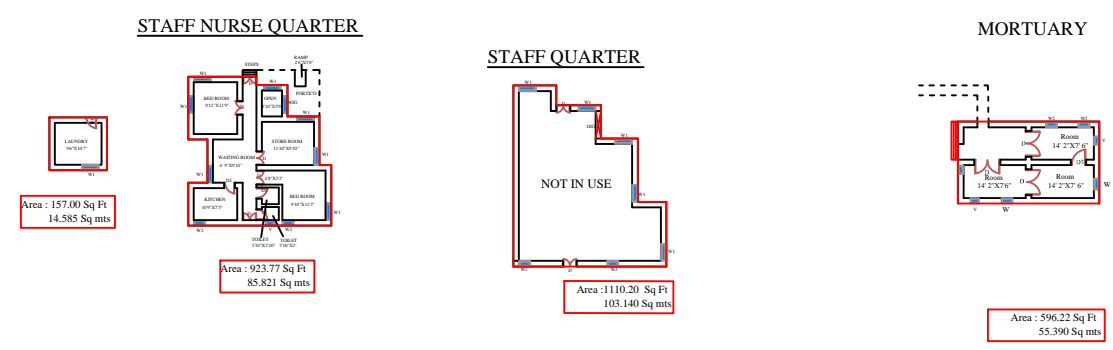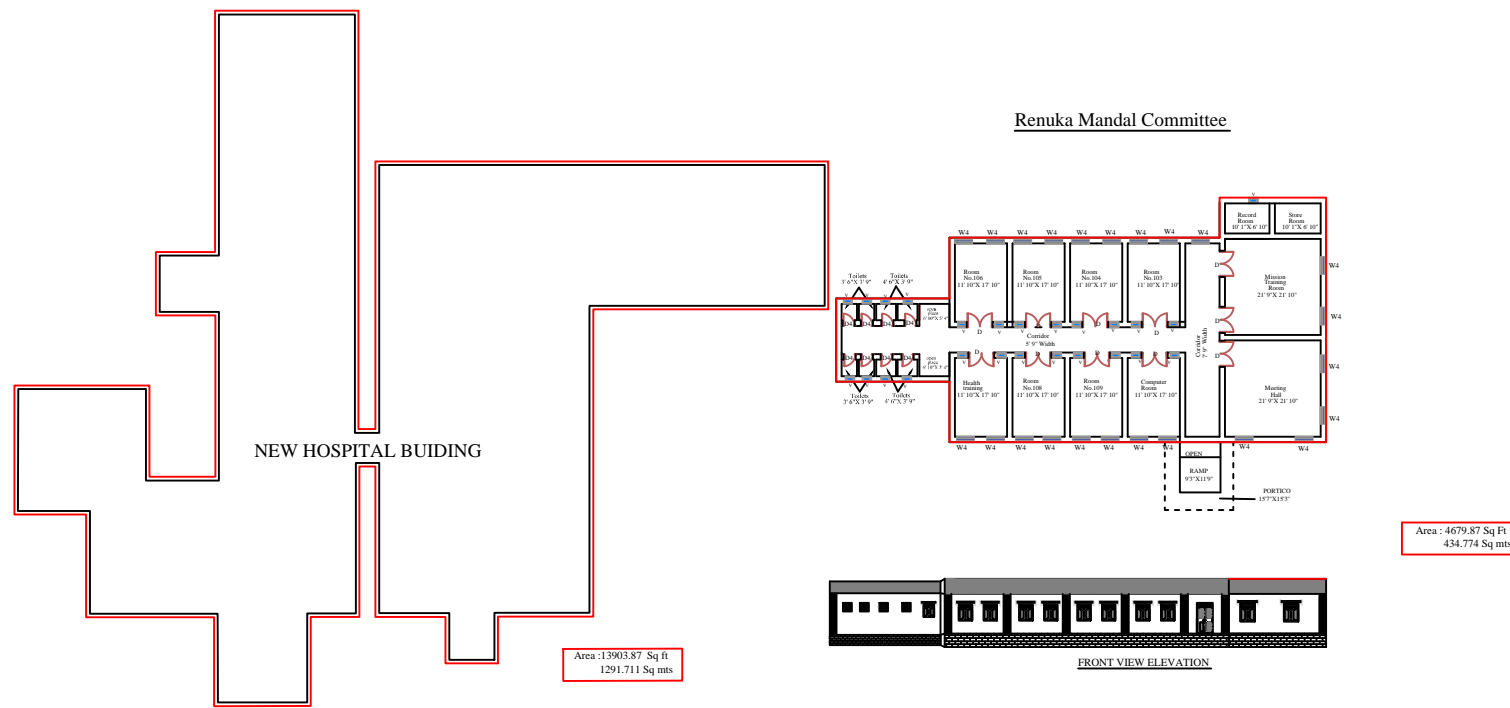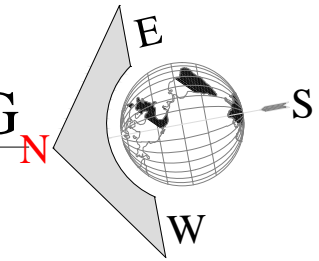

SCALE : 1"=28'

**REFERENCE**

- D1..... 5' 11"
- D2..... 4' 11"
- D3..... 3' 6"
- D4..... 2' 9"
- WALL THICKNESS.....1' 3"
- W.....8' 11"
- W1.....3'
- W2.....3' 11"
- VENTILATOR..... 2'
- W4.....3' 11"

**SITE :-**

COMMUNITY HEALTH CENTER  
HUSNABAD  
KARIMNAGAR DIST.  
TELANGANA STATE

**AREA DETAILS**

21370.93 Sq. ft. 1985.421 Sq.mts

**DRAWING TITLE**

GROUND FLOOR &  
ELEVATION PLAN

SCALE = 1:1

**CLIENT**

TELANGANA STATE MEDICAL  
SERVICE INFRASTRUCTURE  
DEVELOPMENT CORPORATION  
3 rd floor,DM&HS Campus,sultan bazaar,  
Koti, Hyderabad,T.S.-500095.  
040-24619123. Telefax : 040-24619120.


**CONSULTANT**



BHARGAV BUILDPRO TECHNOLOGIES PVT LTD.  
ARCHITECTURE / ENGINEERING / INTERIORS / PROJECT MANAGEMENT  
H. NO - 3-6-213/2, 1 FLOOR, ST. NO. - 16, HIMAYATNAGAR,  
HYDERABAD 500029. PH :- 040-23220974,  
FAX :- 040-23220973  
EMAIL : bhargavassociateshyderabad@gmail.com

YEAR OF CONSTRUCTION : 1980,2013.


# HUSNABAD COMMUNITY HEALTH CENTER ASSET MAP

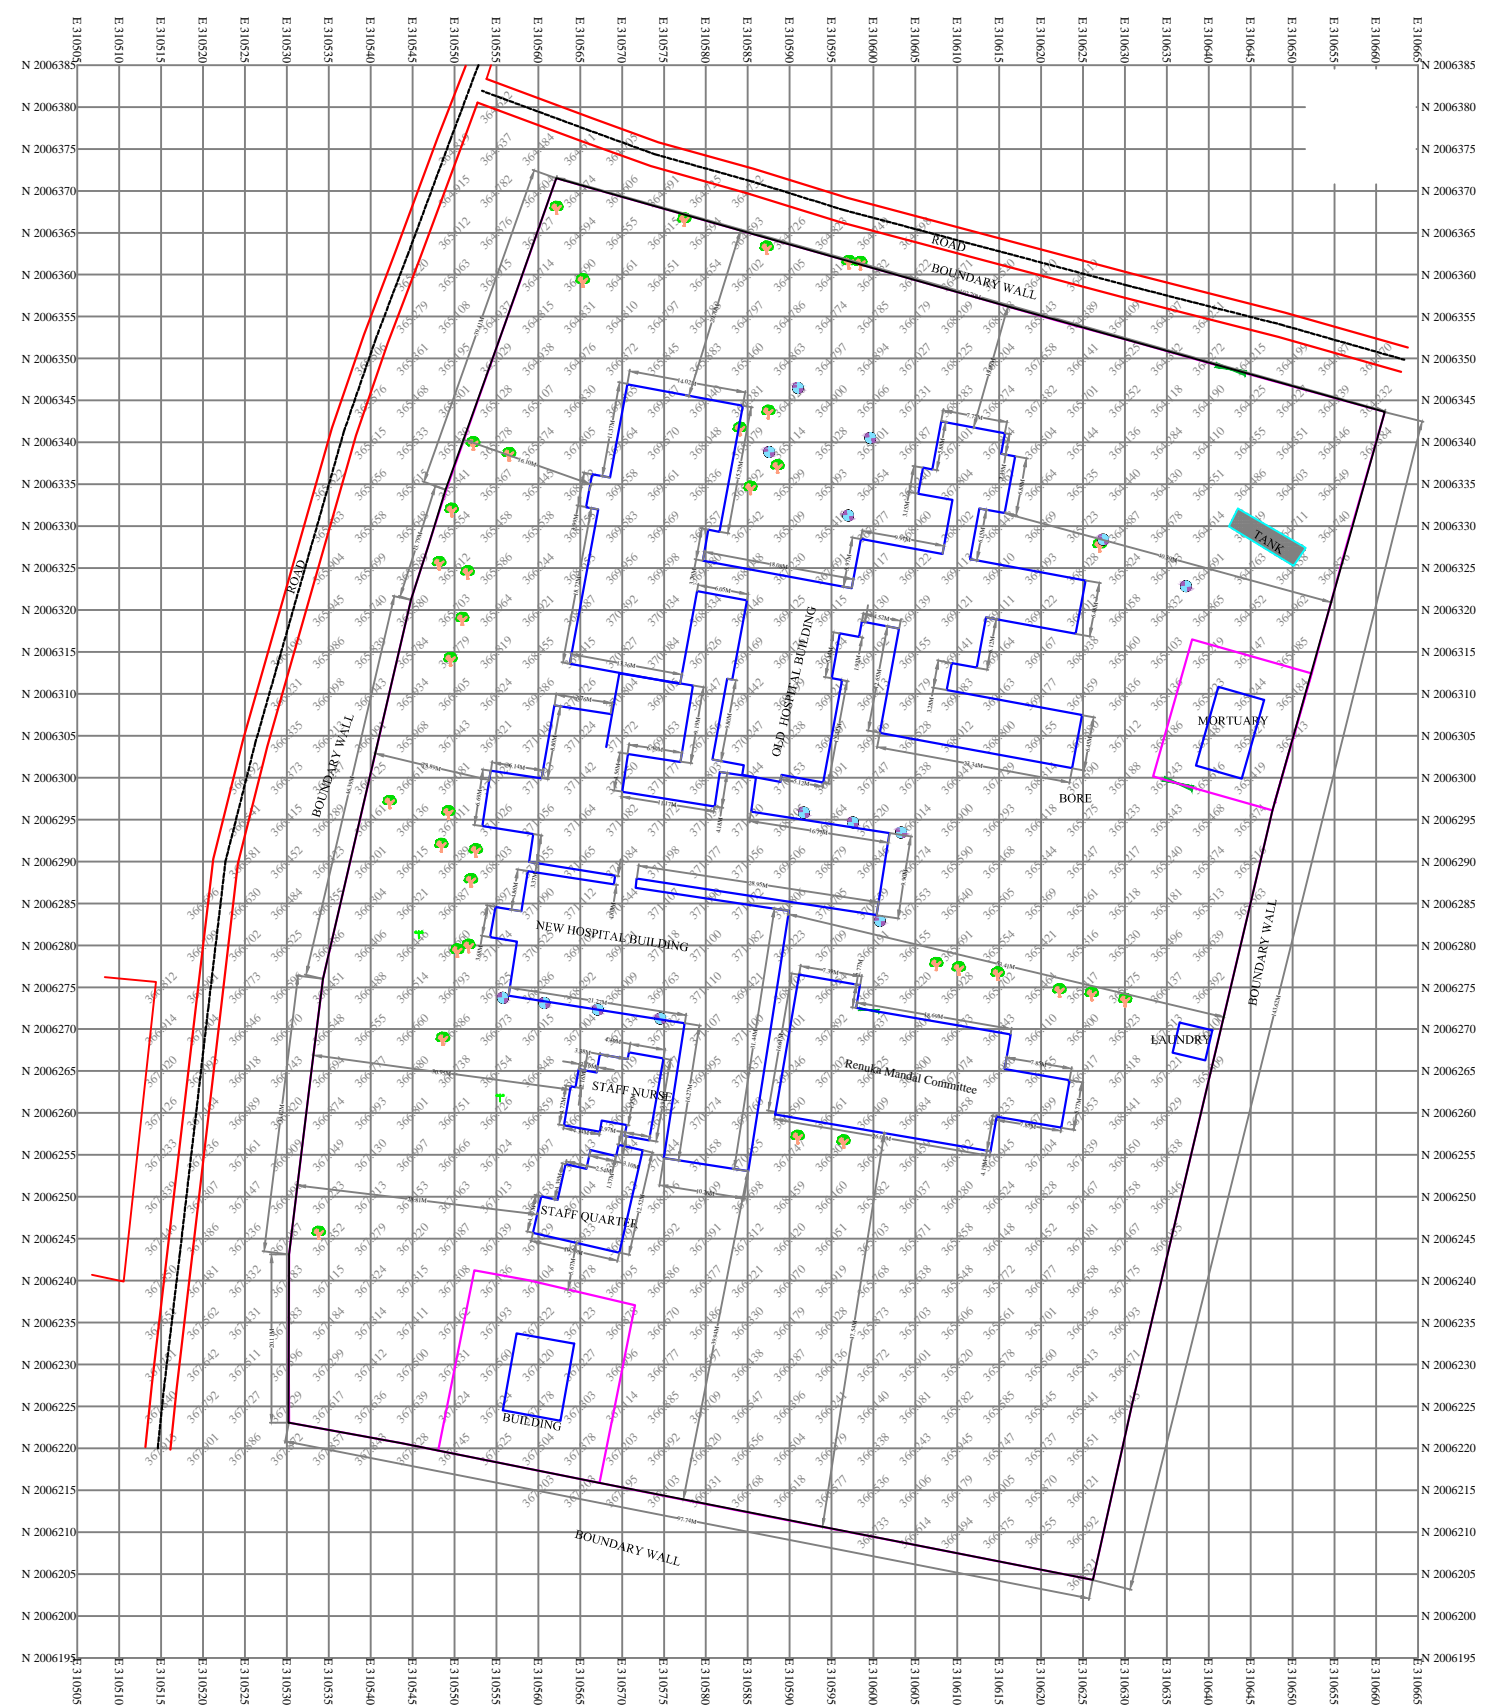

**SITE :-**  
 COMMUNITY HEALTH CENTER  
 HUSNABAD  
 KARIMNAGAR  
 TELANGANA STATE


**AREA DETAILS**  
 15386.942 Sq mts.  
 18402.627 Sq yrd.  
 3.802 Acres.

- REFERENCE**
- BOUNDARY.....
  - BUILDING.....
  - TREE.....
  - ROAD.....
  - GATE.....
  - MANHOLE.....
  - SEPTIC TANK.....
  - BIOPIT.....
  - BORE.....
  - FLAG.....
  - ELECTRICAL POLE.....
  - SEPTIC TANK.....

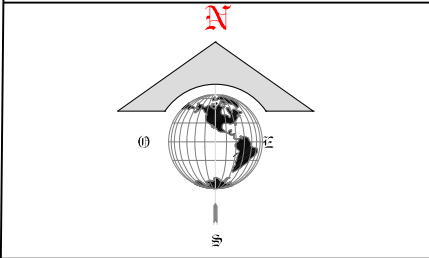

SOFTCOPY SCALE = 1:1000


**CLIENT**  
 TELANGANA STATE MEDICAL  
 SERVICE INFRASTRUCTURE  
 DEVELOPMENT CORPORATION  
 3 rd floor,DM&HS Campus,sultan bazaar,  
 Koti, Hyderabad,T.S.-500095.  
 040-24619123. Telefax : 040-24619120.

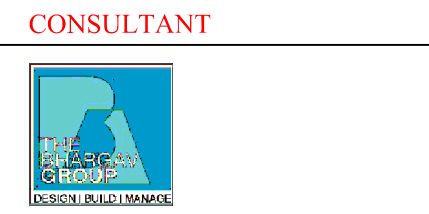

**CONSULTANT**  
 BHARGAV BUILDPRO TECHNOLOGIES PVT LTD.  
 ARCHITECTURE / ENGINEERING / INTERIORS / PROJECT MANAGEMENT  
 H. NO :- 3-6-213/2,1 FLOOR, ST. NO. - 16, HIMAYATNAGAR,  
 HYDERABAD 500029. PH :- 040-23220974,  
 FAX :- 040-23220973  
 EMAIL : bhargavassociateshyderabad@gmail.com

YEAR OF CONSTRUCTION:1980,2013.

# HUSNABAD COMMUNITY HEALTH CENTER LAYOUT

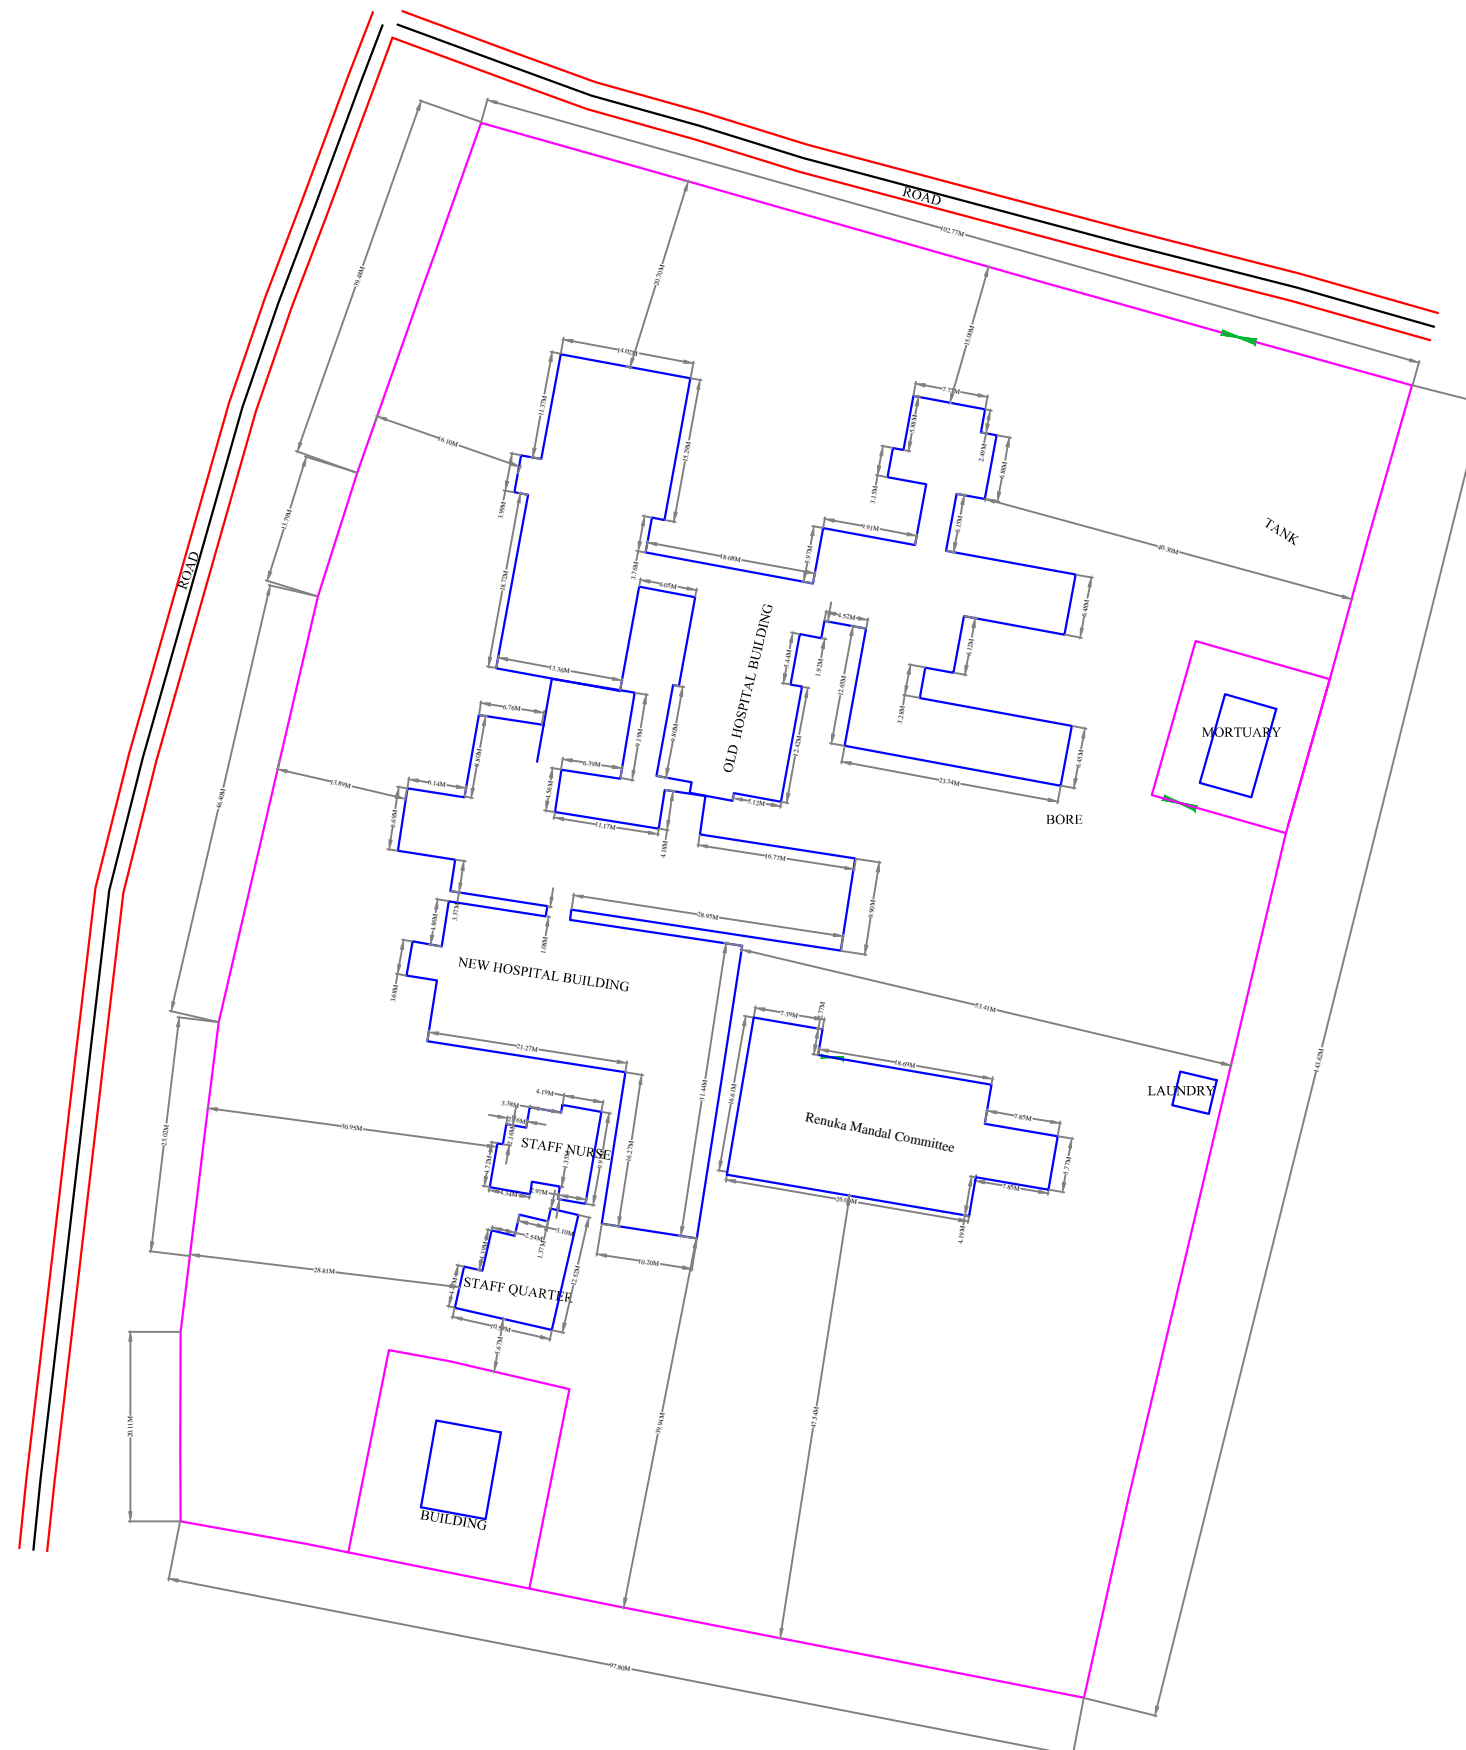

YEAR OF CONSTRUCTION:1980,2013.

## SITE :-


COMMUNITY HEALTH CENTER  
HUSNABAD  
KARIMNAGAR  
TELANGANA STATE

## AREA DETAILS

15386.942 Sq mts.  
18402.627 Sq yrd.  
3.802 Acres.

## REFERENCE

BOUNDARY..... ————  
BUILDING..... □  
ROAD..... ————  
GATE..... ————

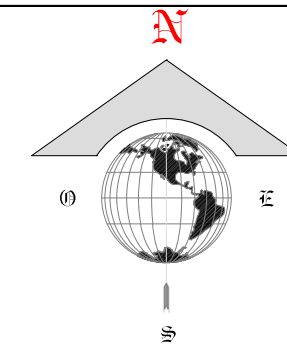

SOFTCOPY SCALE = 1:1000

## CLIENT

TELANGANA STATE MEDICAL  
SERVICE INFRASTRUCTURE  
DEVELOPMENT CORPORATION

3 rd floor,DM&HS Campus,sultan bazaar,  
Koti, Hyderabad,T.S.-500095.  
040-24619123. Telefax : 040-24619120.

## CONSULTANT



BHARGAV BUILDPRO TECHNOLOGIES PVT LTD  
ARCHITECTURE / ENGINEERING / INTERIORS / PROJECT MANAGEMENT  
H. NO : 3-6-213/2, 1 FLOOR, ST. NO. - 16, HIMAYATNAGAR,  
HYDERABAD 500029. PH :- 040-23220974,  
FAX :- 040-23220973

EMAIL : bhargavassociateshyderabad@gmail.com