



TERRACE FLOOR PLAN

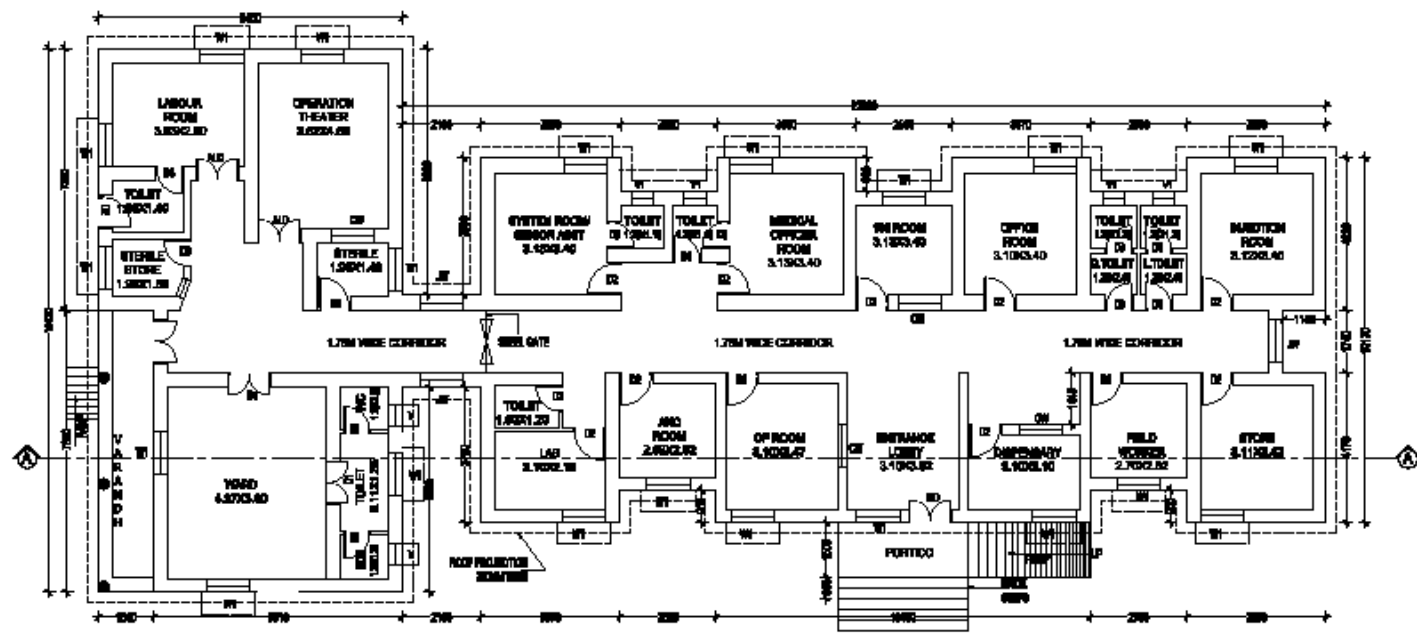

GROUND FLOOR PLAN PHC BLOCK-A

NOTE:
 1. CONTRACTOR TO CHECK AND VERIFY ALL DIMENSIONS BEFORE EXECUTION OF THE WORK.
 2. PROVIDED DIMENSIONS SHALL BE FOLLOWED.
 3. ALL DIMENSIONS GIVEN ARE IN MILLIMETERS UNLESS OTHERWISE SPECIFIED.

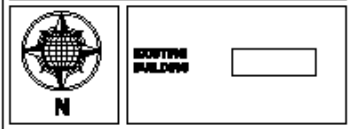

DESCRIPTION OF PHC BLOCK-A

STRUCTURE	MS Steel Structure & Masonry Structure
BUILT UP AREA	GROUND FLOOR - 2670 Sq.M
PLANNED FLOORING	GROUND FLOOR
FINISH HEIGHT OF THE INTERCOMPARABLE FLOOR LEVEL	3.05 M
FLOOR TYPE	CONCRETE
TYPE OF CONSTRUCTION	SI-SCHEM
ASSEMBLY	STEEL STRUCTURE, REINFORCED CONCRETE FLOORING

SCHEDULE OF OPENINGS

TYPE	DESCRIPTION	SIZE
MD	MAIN DOOR	2800 X 2800
ALD	ALUMINIUM DOOR	1200 X 2800
D1	DOUBLE SHUTTER DOOR	1200 X 2800
D2	DOUBLE SHUTTER DOOR	800 X 2800
D3	SINGLE SHUTTER DOOR	700 X 2100
WD	WINDOW	1200 X 1200
JW	JALI WINDOW	1200 X 2800
CW	COUNTER WINDOW	1200 X 1200
V	VENTILATOR	600 X 300

AREA STATEMENT:-
 EXISTING PHC BLOCK-A
 GROUND FLOOR BUILT UP AREA = 2670 Sq.M
 PORTICO AREA 800 = 2.70 Sq.M
 TOTAL AREA = 2672.70 Sq.M

CLIENT:
 TELANGANA STATE MEDICAL SERVICES AND INFRASTRUCTURE DEVELOPMENT CORPORATION

PROJECT TITLE:
 PREPARATION OF SURVEY MAP AND ASSET MAPPING FOR PHC AT ALLADURU (V) MEDAK DISTRICT

TITLE:
 EXISTING SURVEY LAYOUT PLAN OF MHORU PHC HOSPITAL AT ALLADURU VILLAGE, ALLADURU MHADA, MEDAK DIST, TELANGANA STATE.


GROUND FLOOR PHC BLOCK-A

SCALE	1/10
DATE	JUN 2024
DRAWN	MDAM
CHECKED	VMK


CONVEYED BY:

S. KUMAR
 ARCHITECTS & ENGINEERS
 H.No: 2-4-746/1st Floor, ADRS Hospital Lane,
 10, Anna Nagar, Near Allapuram, Hyderabad - 500012.
 T. S.P. No. : 048-27122206 - 91826622206
 E-mail: s.kumar.architects@gmail.com / s.kumar@sk.com
 web: http://www.s.kumararchitects.com/2024

DRWING: SK-ALLA-PHC-A-01

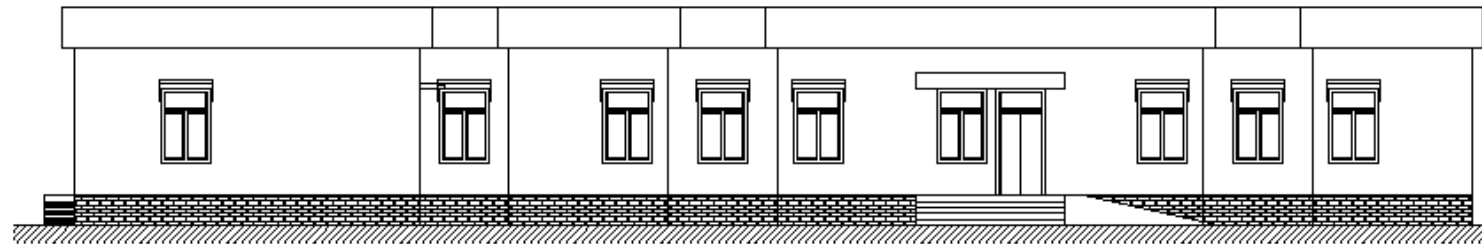

FRONT ELEVATION

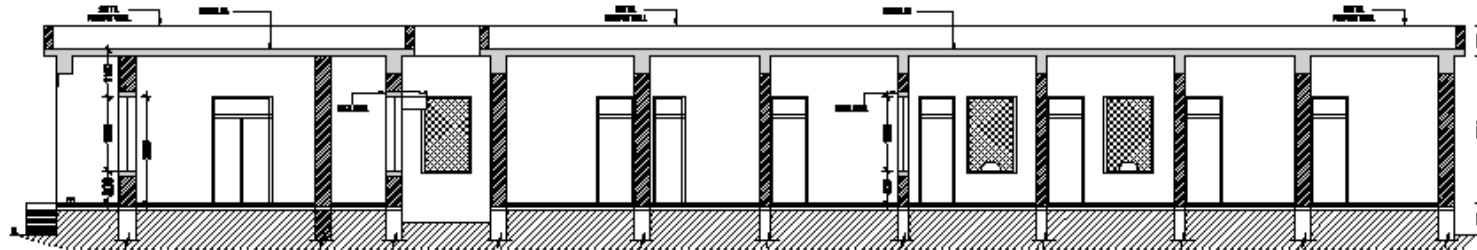

SECTION AT AA'

- NOTE:**
1. CONTRACTOR TO CHECK AND VERIFY ALL DIMENSIONS BEFORE EXECUTION OF THE WORK.
 2. PERMITTED DIMENSIONS SHALL BE FOLLOWED.
 3. ALL DIMENSIONS GIVEN ARE IN MILLIMETERS UNLESS OTHERWISE SPECIFIED.

AREA STATEMENT:-

EXISTING PHC BLOCK-A
 GROUND FLOOR BUILT UP AREA = 281.74 SQM
 PORTICO AREA 88% = 278 SQM
 TOTAL AREA = 559.74 SQM

CLIENT:

TELANGANA STATE MEDICAL
 SERVICES AND INFRASTRUCTURE
 DEVELOPMENT CORPORATION

PROJECT TITLE:

PREPARATION OF SURVEY MAP AND
 ASSET MAPPING FOR PHC AT ALLADURG
 (V) MEDAK DISTRICT

TITLE:

EXISTING SURVEY LAYOUT PLAN OF MANOOR
 PHC HOSPITAL AT ALLADURG VILLAGE,
 ALLADURG MANDAL, MEDAK DIST,
 TELANGANA STATE.

**ELEVATION & SECTION
 PHC BLOCK-A**

NO.	REV

CONTRACTOR:

S. KUMAR
 ARCHITECTS & ENGINEERS
 H.No: 3-3-776/1, 1st Floor, ACPM Hospital Lane,
 6th cross/8th gate, Rajawade Nagar, Hyderabad - 500015.
 T. N.P.L. No: 1-048-0770333-004 / 918 004 8428 004
 E-mail: s.kumar.architects@rediffmail.com
 www: http://www.s.kumararchitects.com/revue

AS BUILT DRAWING

NO. SK-ALLA-PHC-A-02