

**GROUND FLOOR PLAN
PHC DIGWAL(BLOCK-A)**

AS BUILT DRAWING

- NOTE:**
1. CONTRACTOR TO CHECK AND VERIFY ALL DIMENSIONS BEFORE EXECUTION OF THE WORK.
 2. FINISHED DIMENSIONS SHALL BE FOLLOWED.
 3. ALL DIMENSIONS GIVEN ARE IN MILLIMETERS UNLESS OTHERWISE SPECIFIED.



DESCRIPTION OF PRO (BLOCK-A)

SYMBOLS:	PHC (As per Schedule 2, Annexure 1, 2 & 3)
BUILT UP AREA:	GROUND FLOOR - 8681 SQ. M.
PLANNED FLOOR:	GROUND FLOOR
FINISH HEIGHT OF THE STRUCTURE ABOVE FLOOR LEVEL:	3.65 M.
FORM TYPE:	SEALED
TYPE OF CONTRIBUTION:	STABLE WITH EXISTING RECOMMENDED FOR BATHS FLOOR

SCHEDULE OF OPENINGS

TYPE	DESCRIPTION	SIZE
BD	MAIN DOOR	1200 X 2000
ALD	ALUMINIUM DOOR	1200 X 2000
D1	DOUBLE SHUTTER DOOR	1200 X 2000
D2	SINGLE SHUTTER DOOR	800 X 2000
D3	SINGLE SHUTTER DOOR	700 X 2100
W1	WINDOW	1800 X 1800
W2	WINDOW	1800 X 1800
GW	GRILL WINDOW	1200 X 1800
CV	COUNTER WINDOW	1200 X 1200
V1	VENTILATOR	600 X 600

AREA STATEMENT:-
 BUILT UP AREA PHC DIGWAL
 GROUND FLOOR BUILT UP AREA = 8681 SQM
 PORTICO AREA (P.A.) = 1.65 SQM
 TOTAL AREA = 8846 SQM

CLIENT:
 TELANGANA STATE MEDICAL SERVICES AND INFRASTRUCTURE DEVELOPMENT CORPORATION

PROJECT TITLE:
 PREPARATION OF SURVEY MAP AND ASSET MAPPING FOR PHC AT DIGWAL (A) MEDAK DISTRICT

TITLE:
 EXISTING FLOOR PLAN OF PHC HEALTH CENTER IN DIGWAL VILLAGE, JANGHANI MANI, MEDAK DIST, TELANGANA STATE.


**PHC DIGWAL
GROUND FLOOR PLAN**

SCALE:	1/8"
DATE:	JUN 2018
DRAWN BY:	MDAM
CHECKED BY:	WAK


CONSULTANT:

S. KUMAR
 ARCHITECTS & ENGINEERS
 H.No: 3-8-7/46, 1st Floor, ADFM Hospital Lane,
 16th Cross Road, Ramakrishna Nagar, Hyderabad - 500013.
 T. & F. No: 048-2770323/048-2770323/048-2770323/048-2770323
 E-mail: s.kumar.architects@gmail.com / s.kumar@skae.com
 web: http://www.s.kumararchitects.com/office

DWG. NO. SK-DIG-PHC-A-01

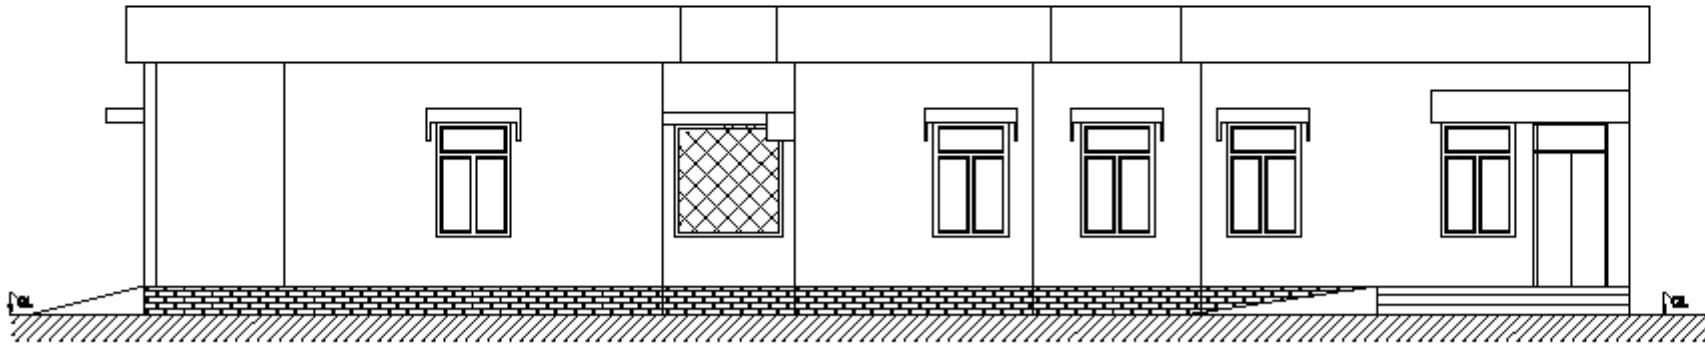

FRONT ELEVATION

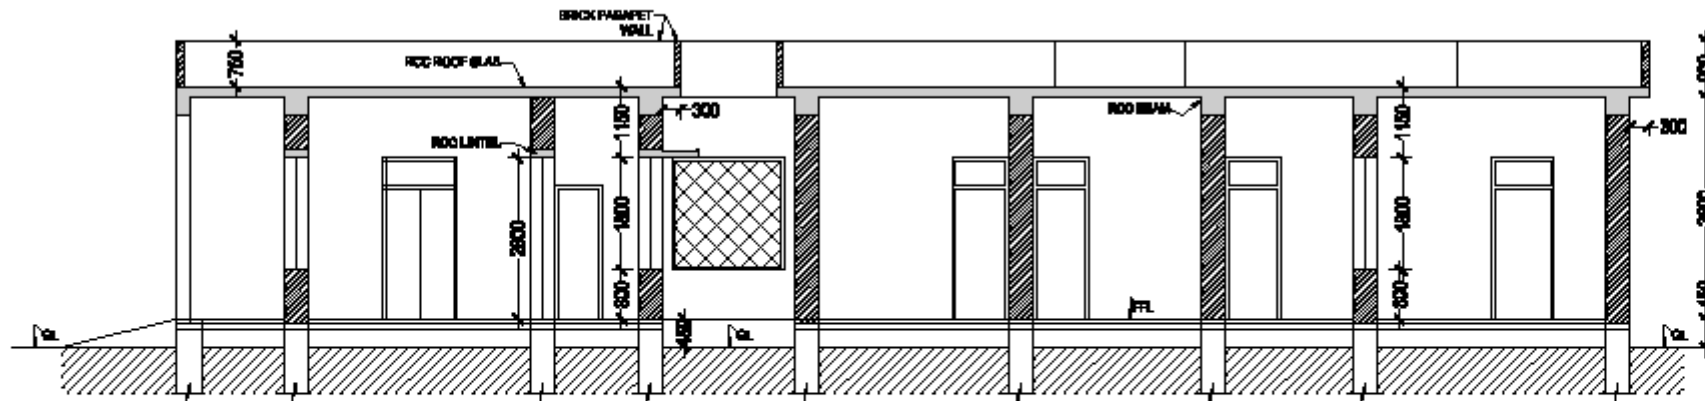

SECTION AT AA'

- NOTE:**
1. CONTRACTOR TO CHECK AND VERIFY ALL DIMENSIONS BEFORE EXECUTION OF THE WORK.
 2. REQUIRED DIMENSIONS SHALL BE FOLLOWED.
 3. ALL DIMENSIONS GIVEN ARE IN MILLIMETERS UNLESS OTHERWISE SPECIFIED.

CLIENT:
 TELANGANA STATE MEDICAL SERVICES AND
 INFRASTRUCTURE DEVELOPMENT
 CORPORATION

PROJECT TITLE:
 PREPARATION OF SURVEY MAP AND
 ASSET MAPPING FOR PHC AT
 DIGVAL(V) MEDAK DISTRICT

TITLE:
 EXISTING SURVEY LAYOUT PLAN OF PHC AT DIGVAL(V)
 DISTRICT MEDAK, MEDAK DISTRICT,
 TELANGANA STATE

**PHC DIGVAL
 ELUVATHI & BROTHER BLOCK-2A**

SCALE	1/10
DATE	JUN 2024
DRAWN	MDAM
CHECKED	WAK

CONSULTANT:

S. KUMAR
 ARCHITECTS & ENGINEERS

H.No: 3-8-7/66, 1st Floor, ADFM Hospital Lane,
 16th Cross Street, Ramakrishna Nagar, Hyderabad - 500113.
 T. & F. No: 048-37333339 | 918 00833339
 E-mail: s.kumar.architects@gmail.com | s.kumar@skae.com
 web: http://s.kumararchitects.com/skae

AS BUILT DRAWING

DWG. NO. SK-DIG-PHC-A-03

- NOTE:**
1. CONTRACTOR TO CHECK AND VERIFY ALL DIMENSIONS BEFORE EXECUTION OF THE WORK.
 2. FINISHED DIMENSIONS SHALL BE FOLLOWED.
 3. ALL DIMENSIONS GIVEN ARE IN MILLIMETERS UNLESS OTHERWISE SPECIFIED.



DESCRIPTION OF BLOCK (BLOCK-B)

APPROXIMATE	1000 Sq. Meters (27000 Sq. Feet)
BUILT UP AREA	GROUND FLOOR - 4640 SQM
PLANNED OR EXISTING	EXISTING FLOOR
PERMANENT HEIGHT OF THE BUILDING ABOVE FLOOR LEVEL	3.60 M
FORMER TYPE	HIGH RISE
TYPE OF CONTRIBUTION	—
ASSESSMENT	STABLE WITH NO URGENT RECOMMENDATIONS FOR FURTHER FLOORING

SCHEDULE OF OPENINGS

TYPE	DESCRIPTION	SIZE
D1	SINGLE SHUTTER DOOR	1000 X 2100
D2	SINGLE SHUTTER DOOR	800 X 2100
D3	SINGLE SHUTTER DOOR	700 X 2100
W1	WINDOW	1200 X 1200
W2	WINDOW	800 X 1200
V1	VENTILATOR	600 X 300

AREA STATEMENT:-
 SQUARE METER (SQ. M) OF BLOCK DIGWAL
 GROUND FLOOR BUILT UP AREA = 4640 SQM

CLIENT:
 TELANGANA STATE MEDICAL SERVICES AND INFRASTRUCTURE DEVELOPMENT CORPORATION

PROJECT TITLE:
 PREPARATION OF SURVEY MAP AND ASSET MAPPING FOR PHC AT DIGWAL (R) MEDAK DISTRICT

TITLE:
 EXISTING FLOOR PLAN OF PHC HEALTH CENTER IN DIGWAL VILLAGE, JANGHAMMURI MANAL, MEDAK DIST, TELANGANA STATE.


OP BLOCK DIGWAL
 GROUND FLOOR PLAN PHC (BLOCK-B)

SCALE	1/10
DATE	JAN 2024
DRAWING	MDAM
DESIGNED	WAK


CONSULTANT:

S. KUMAR
 ARCHITECTS & ENGINEERS
 H.No: 3-8-7/68, 1st Floor, ADFM Hospital Lane,
 500012, Hyderabad, Telangana, India
 T. N.P. No: 048-275102304 | 918048102304
 E-mail: s.kumar@skae.com | s.kumar@skae.com
 web: http://www.skare.com/india


DWG. NO. SK-DIG-OP-A-01

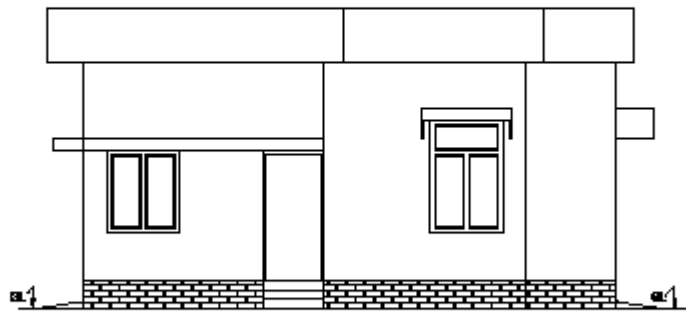


FRONT ELEVATION

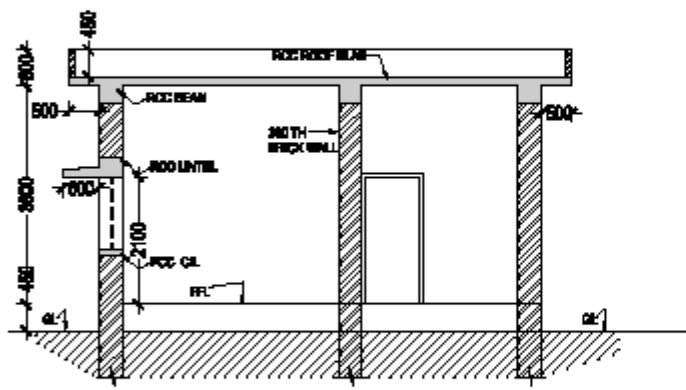

SECTION AT AA'

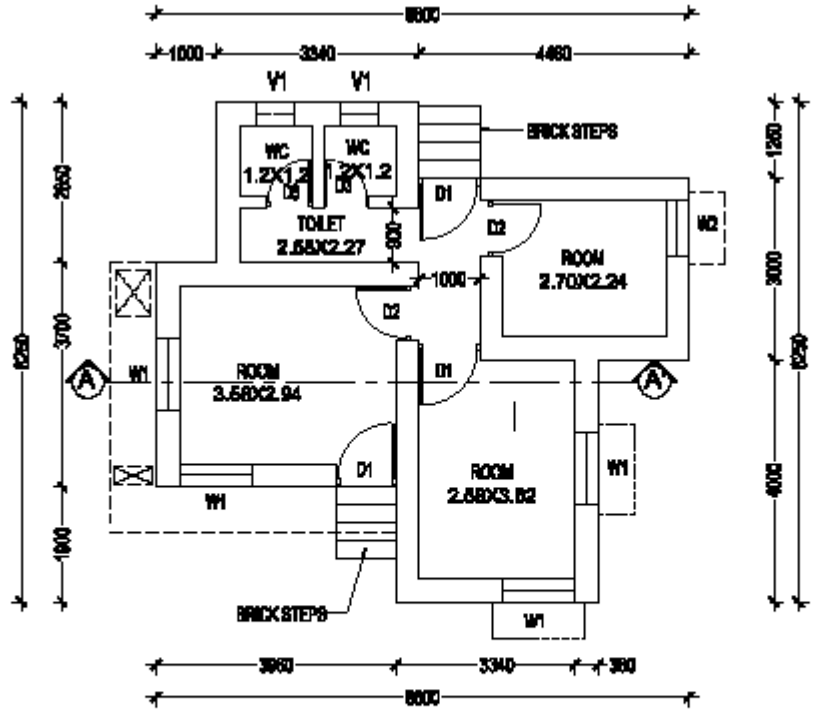

GROUND FLOOR PLAN OP BLOCK DIGWAL (BLOCK-B)

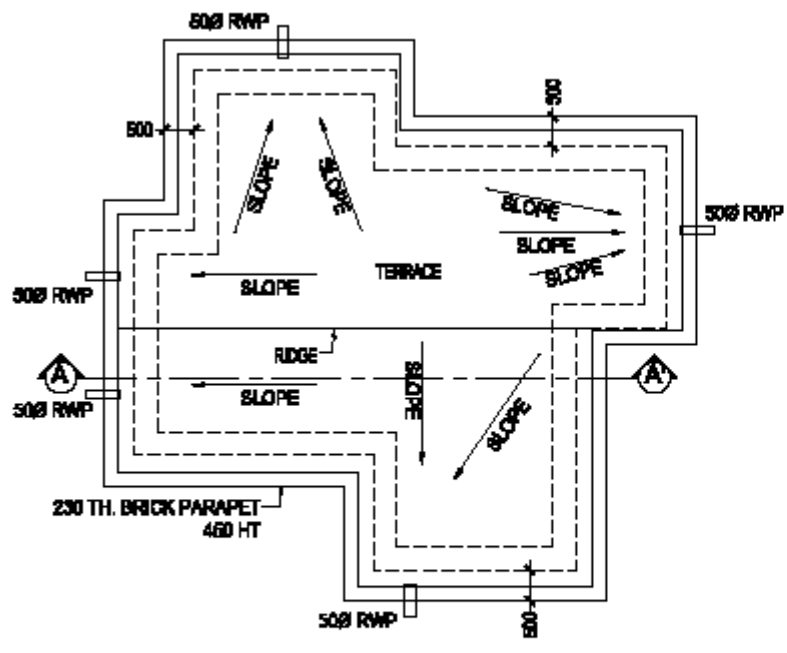

TERRACE PLAN

AS BUILT DRAWING

