



**EXISTING SURVEY LAYOUT PLAN OF UHC HOSPITAL IN NARSAPUR VILLAGE
SIDDIPET MANDAL, MEDAK DIST, TELANGANA STATE.**

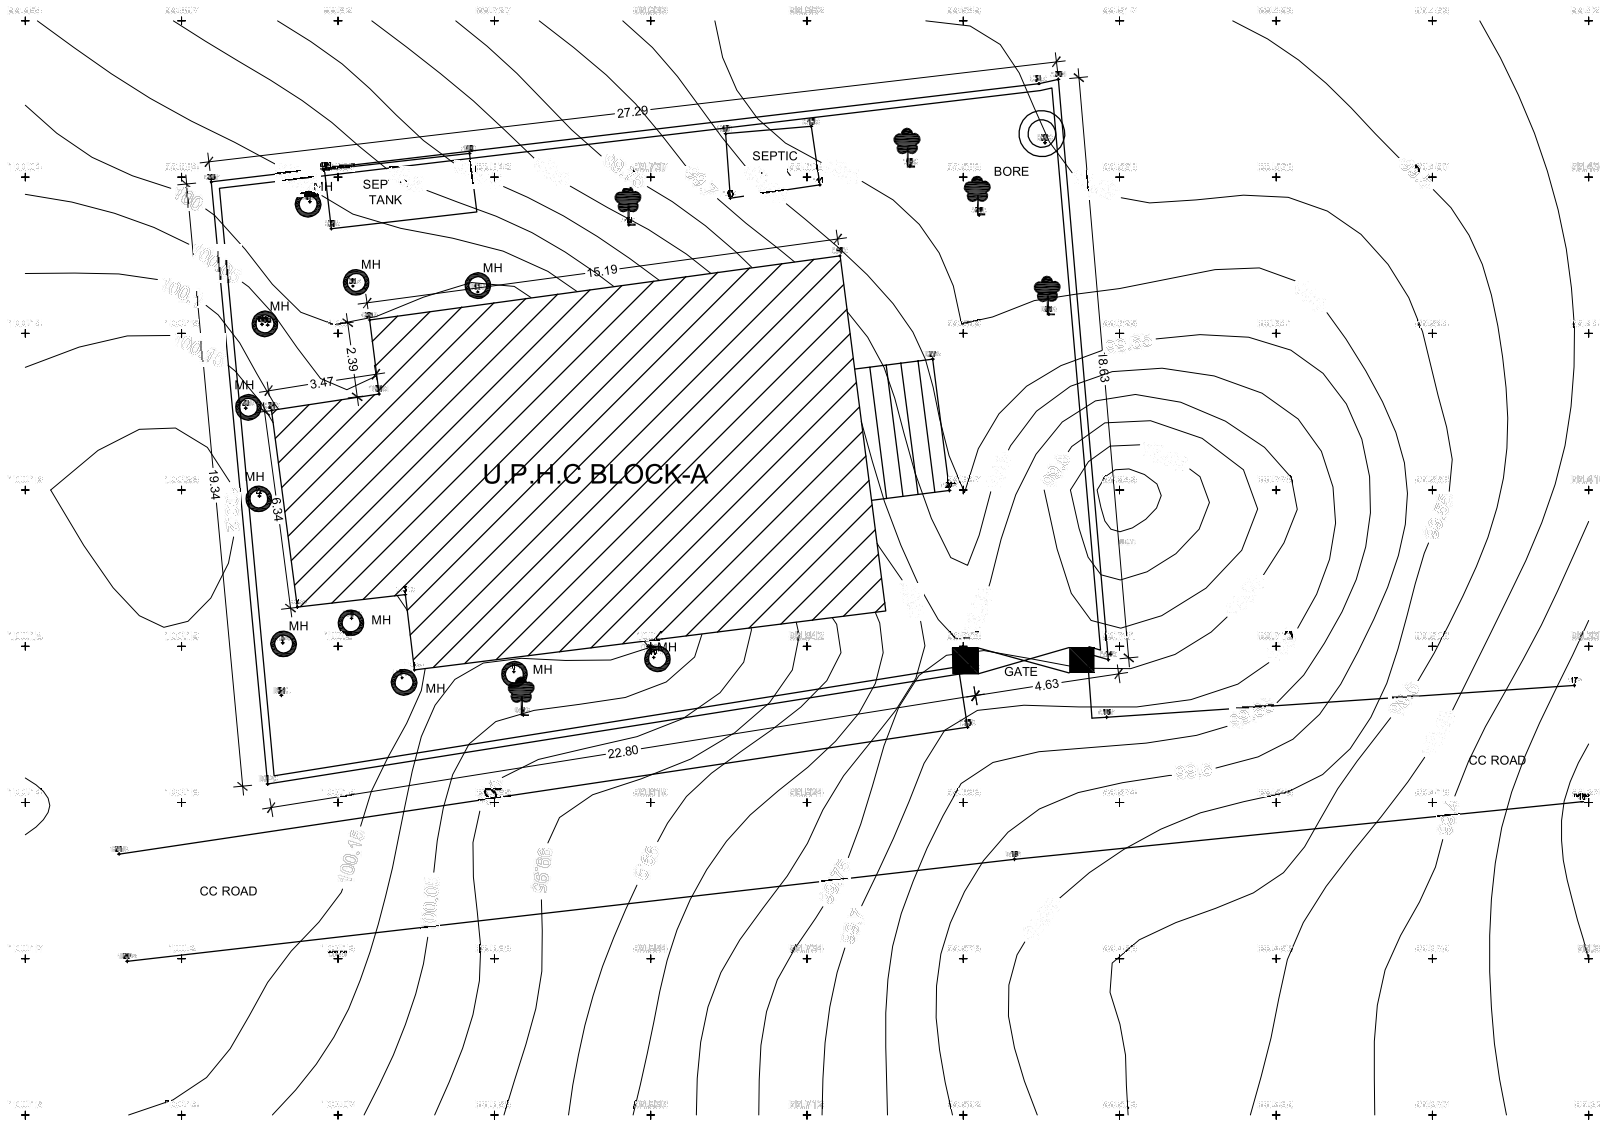

1. CONTRACTOR TO CHECK AND VERIFY ALL DIMENSIONS BEFORE EXECUTION OF THE WORK.
2. FIGURED DIMENSIONS SHALL BE FOLLOWED.
3. ALL DIMENSIONS GIVEN ARE IN MILLIMETERS UNLESS OTHERWISE SPECIFIED.

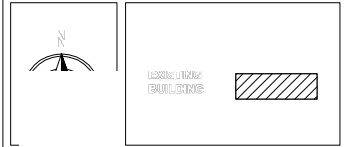

ROAD	
BOUNDARY LINE	
MAN HOLE	MH MH
BORE WELL	
ELECTRIC POLE	EP

SCALE: 1:1000
 DATE: 10/05/2016
 DRAWN: ASP
 CHECKED: VRNK

PROJECT TITLE:
 TO PROVIDE UHC HOSPITAL IN NARSAPUR VILLAGE, SIDDIPET MANDAL, MEDAK DIST, TELANGANA STATE.

CLIENT:
 TELANGANA STATE MEDICAL SERVICES AND INFRASTRUCTURE DEVELOPMENT CORPORATION

PROJECT TITLE:
 TO PROVIDE UHC HOSPITAL IN NARSAPUR VILLAGE, SIDDIPET MANDAL, MEDAK DIST, TELANGANA STATE.

PROJECT TITLE:
 EXISTING SURVEY LAYOUT PLAN OF UHC HOSPITAL IN NARSAPUR VILLAGE, SIDDIPET MANDAL, MEDAK DIST, TELANGANA STATE.


EXISTING SITE PLAN

SCALE	NTS
DATE	NON 2016
DRAWN	ASP
CHECKED	VRNK


DESIGNER:

 S.K. Narsapur Engineering & Construction Pvt. Ltd.
 Plot No. 10, 11, 12, 999, 1000.

PROJECT TITLE:
SK-NAR-LP-A-01

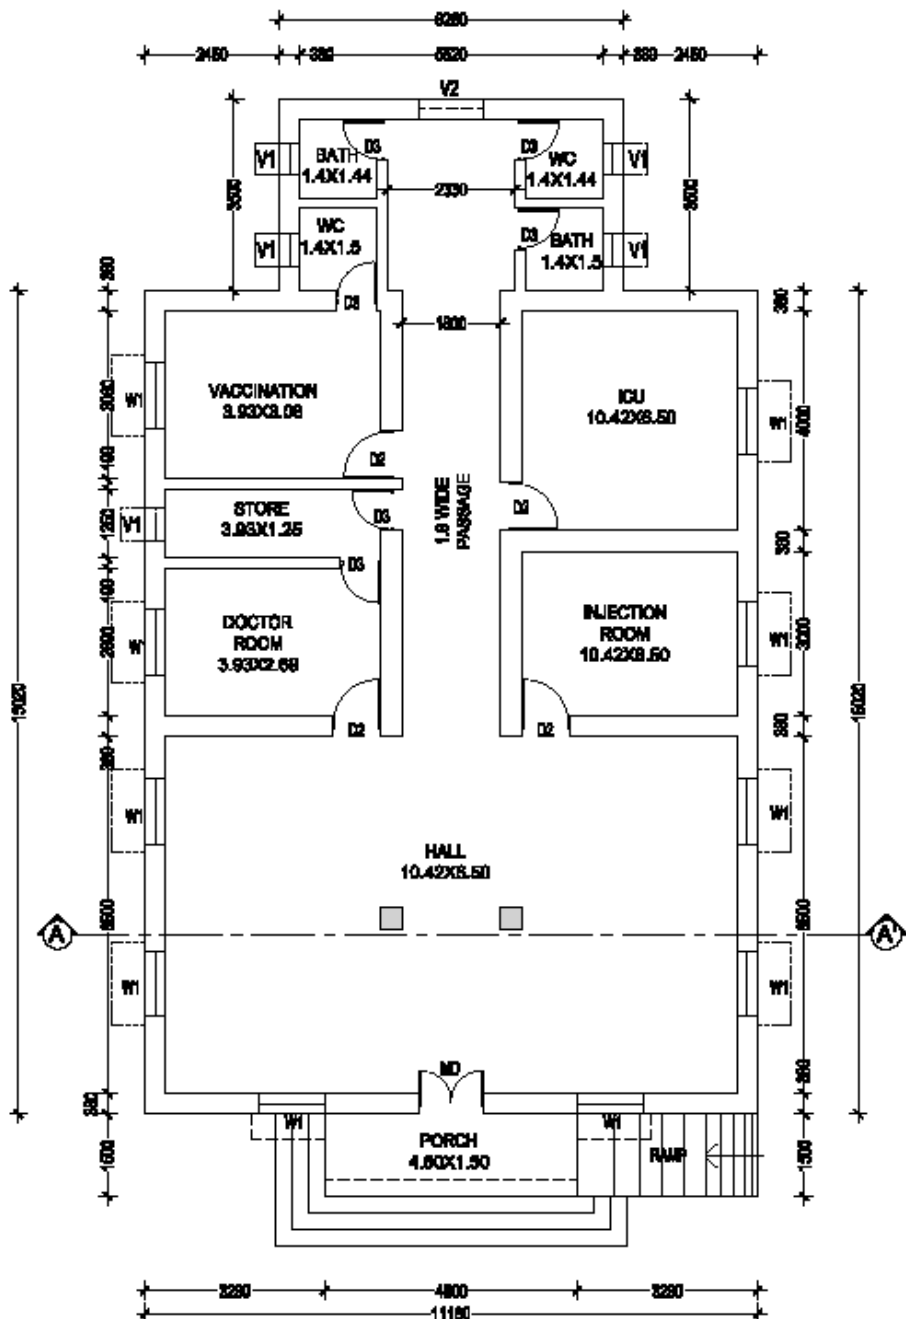

**GROUND FLOOR PLAN
UPHC BLOCK-A**

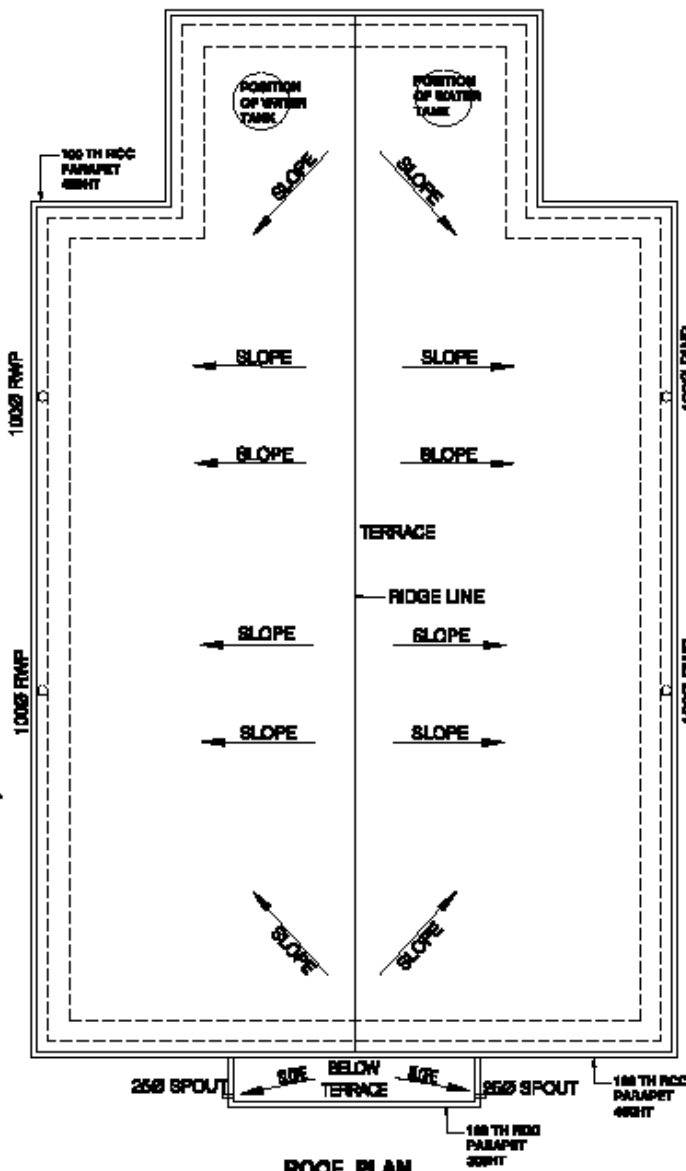

ROOF PLAN

AS BUILT DRAWING

- NOTE :**
1. CONTRACTOR TO CHECK AND VERIFY ALL DIMENSIONS BEFORE EXECUTION OF THE WORK.
 2. PROVIDED DIMENSIONS SHALL BE FOLLOWED.
 3. ALL DIMENSIONS GIVEN ARE IN MILLIMETERS UNLESS OTHERWISE SPECIFIED.



DESCRIPTION OF WORK/DESCRIPTION - SCOPE	
STRUCTURE	ROOF STRUCTURE EXISTING STRUCTURE
BUILT UP AREA	GROUND FLOOR - 11180 SQM
FLOORING OF FLOOR	GROUND FLOOR
NUMBER OF FLOORS	3/3 F
STRUCTURE/FLOOR LINE	SUB B
FOUNDATION	FOUNDATION
YEAR OF CONSTRUCTION	---
ASSESSMENT	STRUCTURE NOT RECOMMENDED FOR REUSE FLOOR

SCHEDULE OF OPENINGS		
TYPE	DESCRIPTION	SIZE
MD	DOUBLE SHUTTER DOOR	1800 X 2000
D1	SINGLE SHUTTER DOOR	900 X 2000
D2	SINGLE SHUTTER DOOR	750 X 2100
W1	WINDOW	1800 X 1800
V1	VENTILATOR	400 X 800
V2	VENTILATOR	1800 X 800

AREA STATEMENT :	
EXISTING OLD BERRY QUARTERS	16.14 SQM
GROUND FLOOR BUILT UP AREA	11180 SQM
PORTICO AREA 10%	1118 SQM
TOTAL AREA	12408 SQM

CLIENT:
TELANGANA STATE REGIONAL SERVICES AND INFRASTRUCTURE DEVELOPMENT CORPORATION

PROJECT TITLE:
PREPARATION OF BERRY MAP AND ASSET MAPPING FOR UPHC AT UPHC NABARPURA (V) SIDDIPET (M) MEDAK DISTRICT

TITLE:
EXISTING SURVEY LAYOUT PLAN OF UPHC NABARPURA (V) SIDDIPET (M) MEDAK DIST, TELANGANA STATE.

**GROUND FLOOR PLAN
UPHC BLOCK-A**


SCALE	1/16
DATE	NOV 2019
DRAWN	SK/N
CHECKED	SK/N

CONSULTANT :


S. KUMAR
ARCHITECTS & ENGINEERS
H. No. 9-9-7448, 1st Floor, ADRS Hyderabad, India.
S. Kumar Nagar, Ramachandrapuram, Hyderabad - 500013.
T. & M. No. : 944-87884133; 9441886888
Email : s.kumar.architects@gmail.com
www : http://www.s.kumar.architects.com/

DESIGN:
SK-NAR-UPHC-A-01

NOTE :
 1. CONTRACTOR TO CHECK AND VERIFY ALL DIMENSIONS BEFORE EXECUTION OF THE WORK.
 2. FINISHED DIMENSIONS SHALL BE FOLLOWED.
 3. ALL DIMENSIONS GIVEN ARE IN MILLIMETERS UNLESS OTHERWISE SPECIFIED.

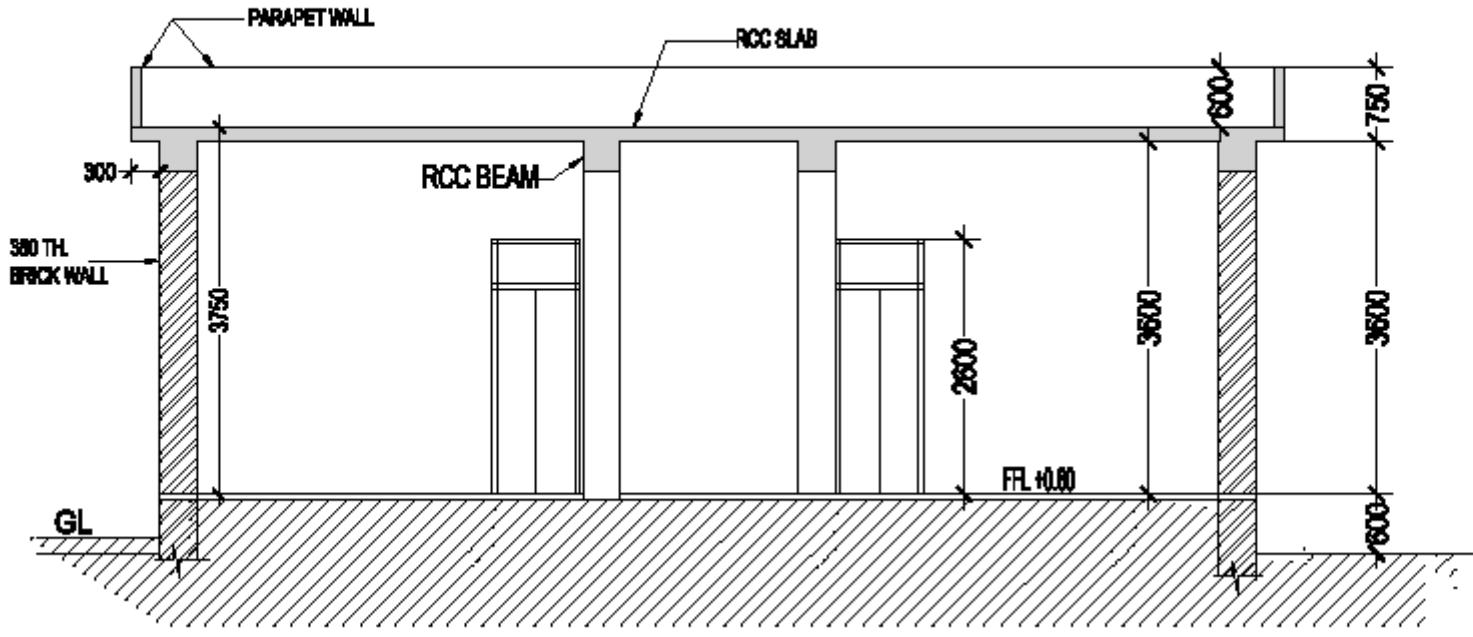

SECTION AT AA'

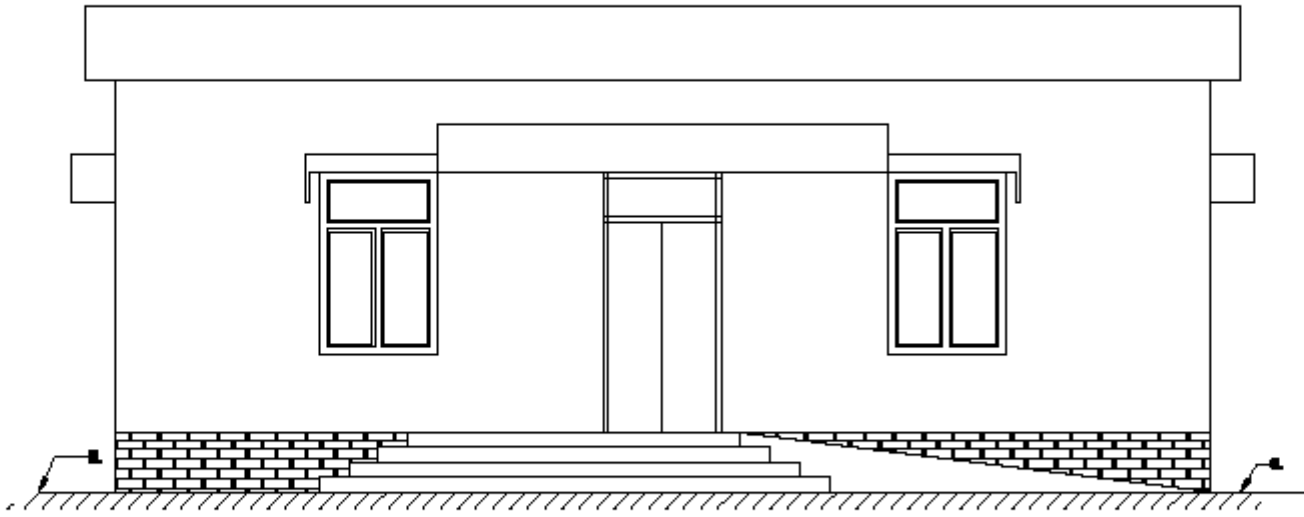

FRONT ELEVATION

AS BUILT DRAWING

CLIENT : TELANGANA STATE MEDICAL SERVICES AND INFRASTRUCTURE DEVELOPMENT CORPORATION

PROJECT TITLE :
 PREPARATION OF SURVEY MAP AND ASSET MAPPING FOR UPHC AT UPHC NABARPURA (V) SIDDPET (M), MEDAK DISTRICT

TITLE :
 EXISTING SURVEY LAYOUT PLAN OF UPHC NABARPURA (V) SIDDPET (M), MEDAK DIST, TELANGANA STATE.

FRONT ELEVATION & SECTION UPHC BLOCK-A


SCALE	1/10
DATE	NOV 2019
DRAWN	SK/KR
CHECKED	SK/KR

CONSULTANT :


S. KUMAR
 ARCHITECTS & ENGINEERS
 H.No: 9-9-7446, 1st Floor, ADRA Hospital Lane,
 Sitaram Nagar, Ramachandrapuram - 500113,
 T. S. P. No : 649-3732222; +918388222222;
 Email : s.kumar.architectsengineers@gmail.com;
 web : http://s.kumar.engineers.com/ksae

DRG. NO. SK-NAR-UHC-A-02

NOTE :
 1. CONTRACTOR TO CHECK AND VERIFY ALL DIMENSIONS BEFORE EXECUTION OF THE WORK.
 2. FINISHED DIMENSIONS SHALL BE FOLLOWED.
 3. ALL DIMENSIONS GIVEN ARE IN MILLIMETERS UNLESS OTHERWISE SPECIFIED.

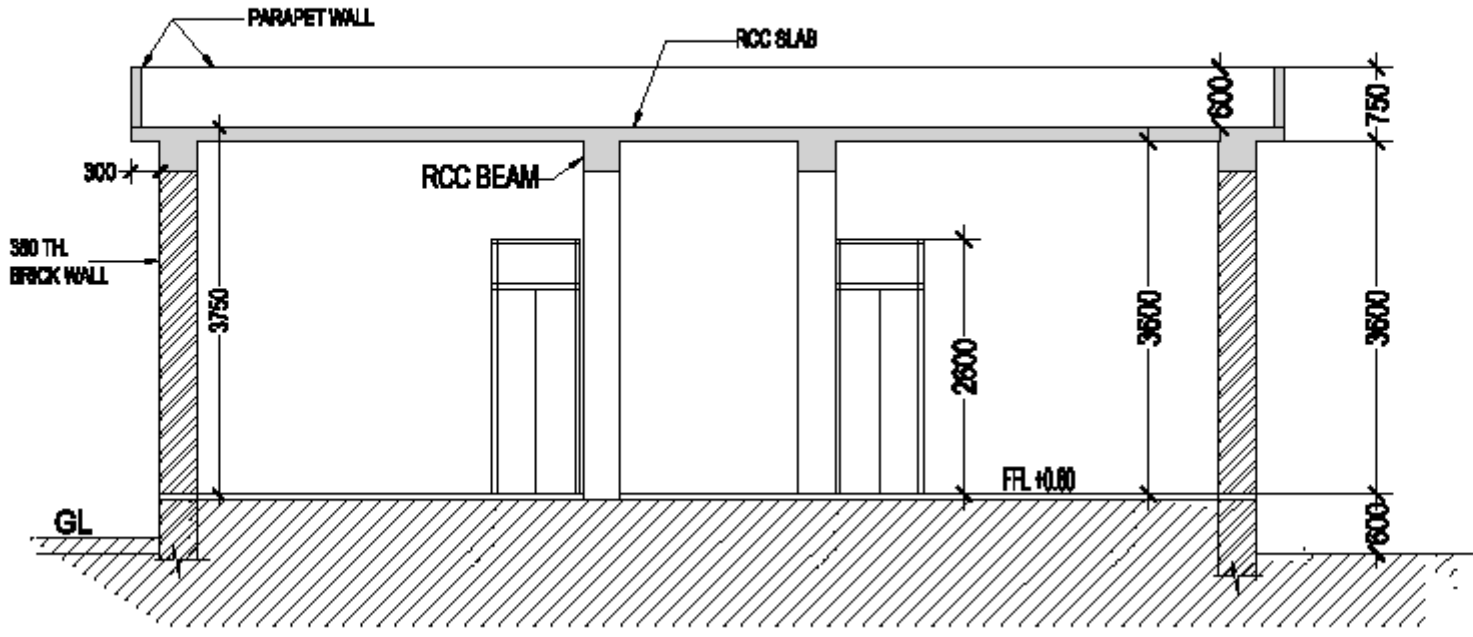

SECTION AT AA'

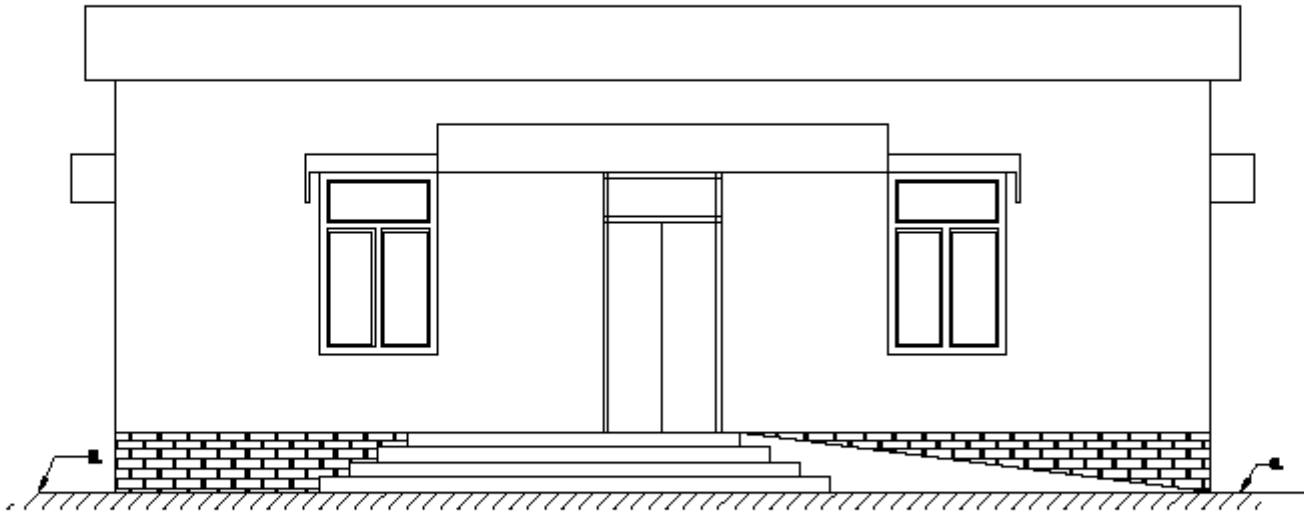

FRONT ELEVATION

AS BUILT DRAWING

CLIENT : TELANGANA STATE MEDICAL SERVICES AND INFRASTRUCTURE DEVELOPMENT CORPORATION

PROJECT TITLE : PREPARATION OF SURVEY MAP AND ASSET MAPPING FOR UPHC AT UPHC NABARPURA (V) SIDDPET (M), MEDAK DISTRICT

TITLE : EXISTING SURVEY LAYOUT PLAN OF UPHC NABARPURA (V) SIDDPET (M), MEDAK DIST, TELANGANA STATE.

FRONT ELEVATION & SECTION UPHC BLOCK-A

SCALE	NOT
DATE	NOV 2019
DRAWN	NOT
CHECKED	YES

CONSULTANT :

S. KUMAR
 ARCHITECTS & ENGINEERS
 H.No: 9-9-7446, 1st Floor, ADRA Hospital Lane,
 Sitaram Nagar, Ramachandrapuram - 500113,
 T. S. P. No : 646-3732222; +918886222222;
 Email : s.kumar.architectsengineers@gmail.com;
 web : http://s.kumararchitects.com/ksae

SCALE : SK-NAR-UHC-A-02

