


SECTION A-A

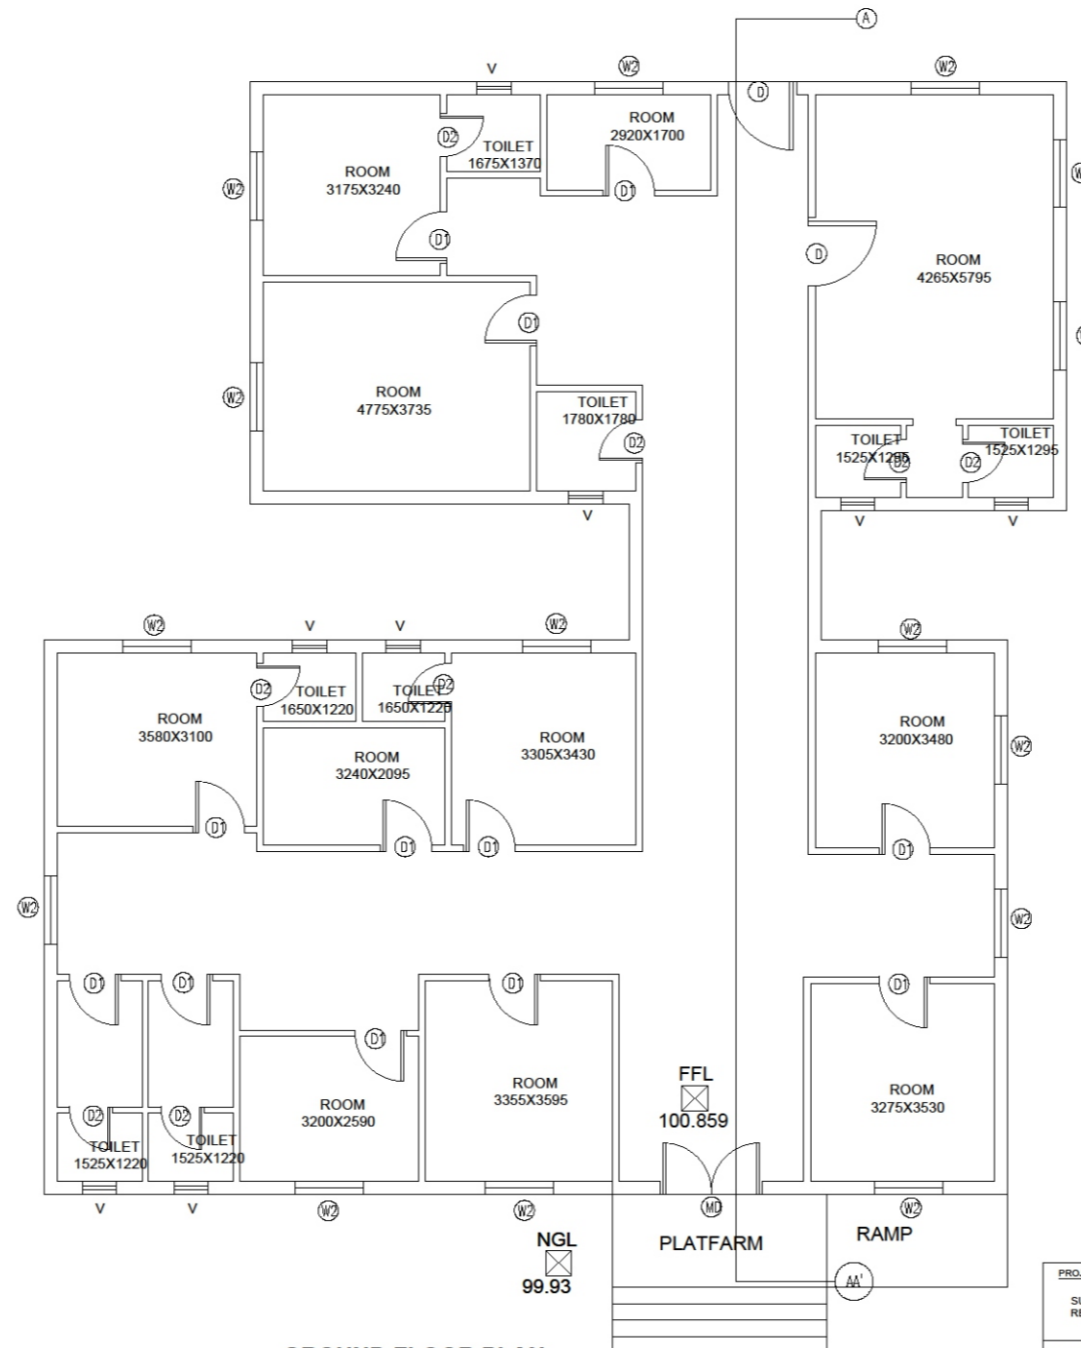

GROUND FLOOR PLAN



**JOINERY DETAILS:-**

Doors :-	Windows :-
MD :- 1.20 x 2.1	W :- 1.45 x 1.65
D :- 1.20 x 2.1	W1 :- 1.80 x 1.65
D1 :- 0.91 x 2.1	W2 :- 1.20 x 1.65
D2 :- 0.75 x 2.1	V :- 0.60 x 0.45

**AREA STATEMENT :-**  
Built Up Area :- 289.82 Sqm

<b>PROJECT TITLE</b>	
SURVEY PLAN OF PHC REPALA SITUATED AT REPALA, NALGONDA DIST.	
<b>DEALT BY</b>	
MAPE CONNOISSEURS 3-4-485/1/D1, 1 FLOOR, Near Bank Of Baroda, OPP. Reddy Women's College, BARKATPURA, HYDERABAD-27. TEL. NO. : 27566409 FAX. NO. : 27566691 E-MAIL : mapedyd1@gmail.com	
<b>DRG. TITLE</b>	
AS BUILT DRAWING	
<b>DRAWN BY :</b> JAGDISH	<b>DATE :</b> 16-06-2016
<b>DRG. NO.</b>	
TSM/DC / PHC HOSPITAL / REPALA /AR-02	

