COPY RIGHT OF THIS DRAWING BELONGS TO M/S S.S.INFRASTRUCTURE AND SHOULD NOT BE USED FOR ANY PURPOSE OTHER THAN SPECIFIED WITHOUT PRIOR PERMISSION.

North :

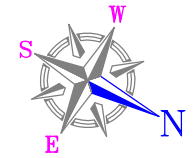

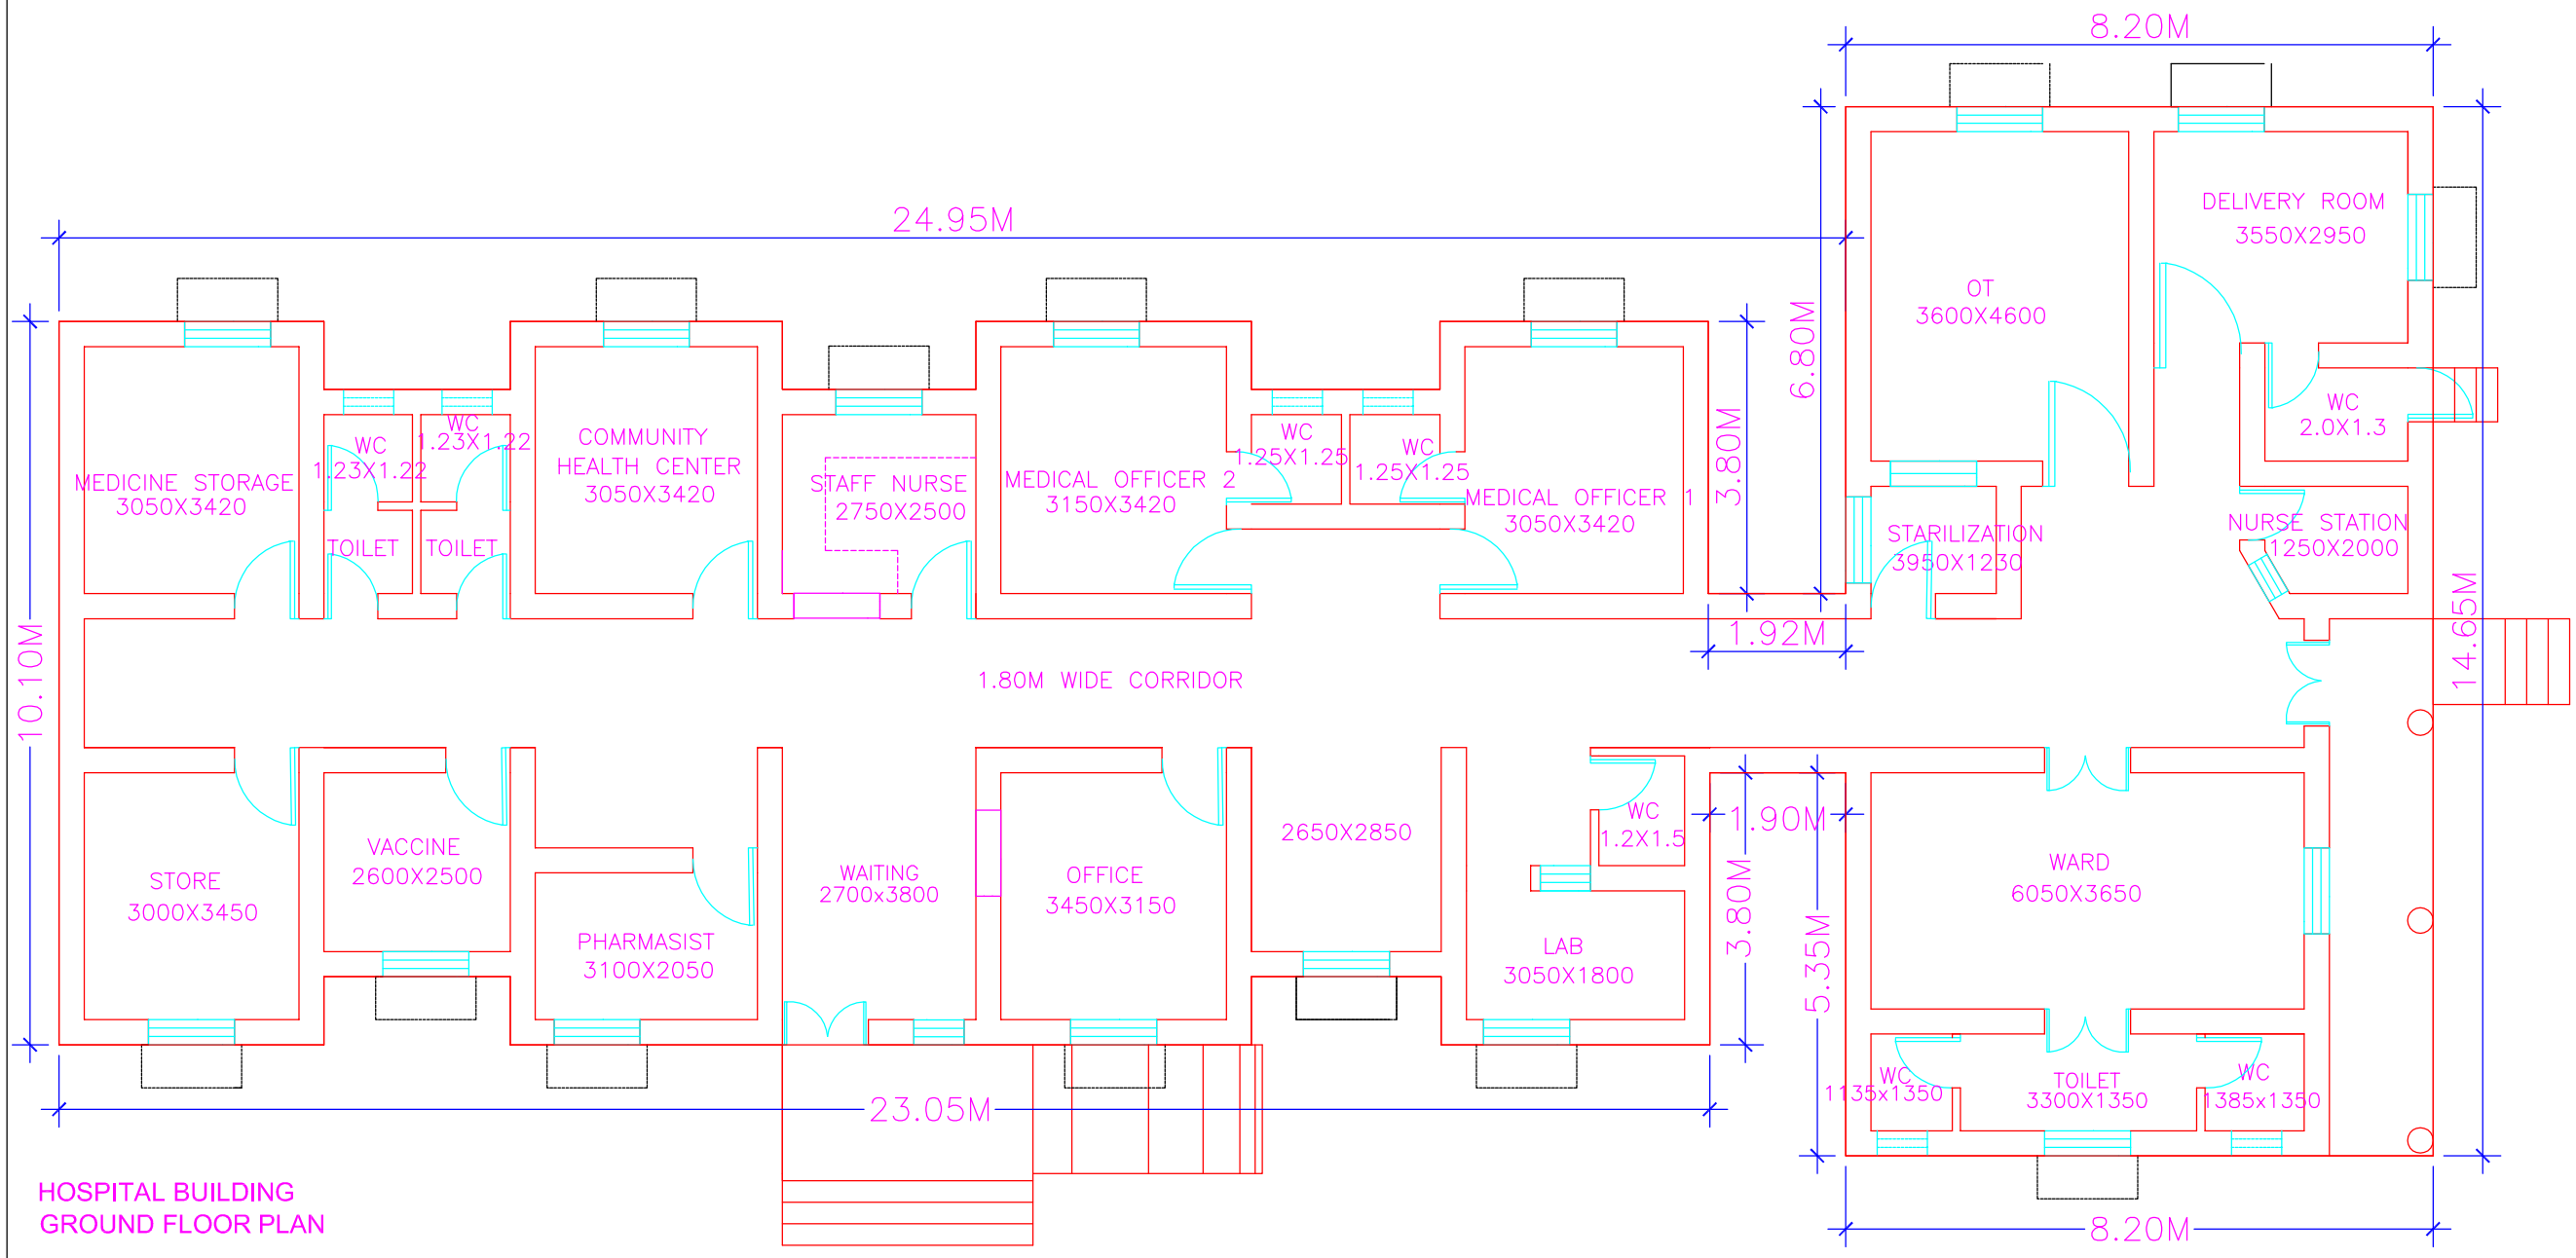

HOSPITAL BUILDING
GROUND FLOOR PLAN

//TRUE COPY//
Executive Engineer
T.S.M.S.I.D.C. DIVISION
NIZAMABAD.

AS BUILT DRAWING

Area:

HOSPITAL MAIN BLOCK	345.08 Sqmts
TOTAL	345.08 Sqmts

STATUS :

EXISTING BUILDING

PROJECT :

SURVEY PLAN AND ASSET MAPPING
FOR HOSPITALS AND MEDICAL COLLEGES
IN NIZAMABAD DISTRICT

TITLE :

PHC-JAKRANPALLY
GROUND FLOOR PLAN

CLIENT :

TELANGANA STATE MEDICAL SERVICES
INFRASTRUCTURE DEVELOPMENT CORPORATION
(An Enterprise of Government of Telangana)
DM & HS CAMPUS
SULTAN BAZAR, KOTI, HYDERABAD.

CONSULTANTS :

S.S.INFRASTRUCTURE
PROJECT CONSULTANTS Pvt.Ltd.
25&9, JABBAR BUILDINGS,
BEGUMPET, HYDERABAD-16
Ph: +9140 66310954, 66310240
FAX No:+91 40 66312949.
email: ssipcpl@gmail.com

DATE :	07-06-2016	SHEET NO:
SCALE :	N.T.S.	03
DEALT BY :	PAVAN	
SURVEYOR :	B.V.RAMANA	
CHECKED BY :	SS RAO	

DRG.NO:- SSIPCPL/TSMSIDC/JAKRANPALLY/HOSPITAL BUILDING/AD-03

NAME OF THE WORK

SURVEY PLAN AND ASSET MAPPING FOR HOSPITALS AND MEDICAL COLLEGES IN THE STATE OF TELANGANA

PRIMARY HEALTH CENTER AT JAKRANPALLY, NIZAMABAD DISTRICT

CLIENT:

TSMSIDC, 2nd floor, DM & HS Campus,
Sultan Bazar, Koti, Hyderabad-500095.

CONSULTANTS

S.S.INFRASTRUCTURE
PROJECT CONSULTANTS Pvt.Ltd.
ISO 9001-2008 Certified
#25 & 9, Jabbar Buildings
Begumpet, Hyderabad- 500 016
Phone: +91 40 66310954, 66310240
Fax: +91 40 66312949, Email: ssipcpl@gmail.com

PRIMARY HEALTH CENTER AT JAKRANPALLY, NIZAMABAD DISTRICT

EXTENT OF AREA	:	**10006.1 SQ.YDS (OR) 2.067 ACRES**
BUILT-UP AREA	:	
HOSPITAL MAIN BLOCK	:	**345.08 SQ.MT (OR) 3714.41 SFT**
TYPE OF BUILDING	:	
HOSPITAL MAIN BLOCK	:	**LOAD BEARING STRUCTURE COVERED RCC ROOF SLAB**
NO OF FLOORS	:	
HOSPITAL MAIN BLOCK	:	**GROUND FLOOR**

"TRUE COPY"

3/6/16

Executive Engineer
T.S.M.S.I.D.C. DIVISION
NIZAMABAD.

PRIMARY HEALTH CENTER AT JAKRANPALLY

ENTRANCE

MEDICAL OFFICER ROOM

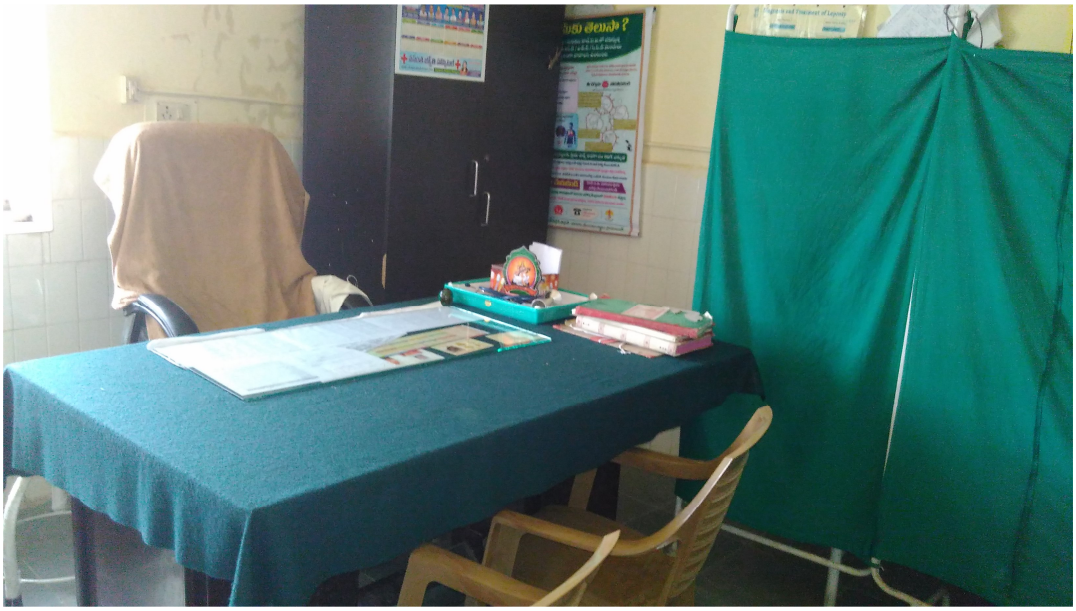

DOCTOR ROOM

LAB

STERILIZATION ROOM

WARD

OPERATION THEATER

LABOUR ROOM

PHARMACY

COMPUTER ROOM

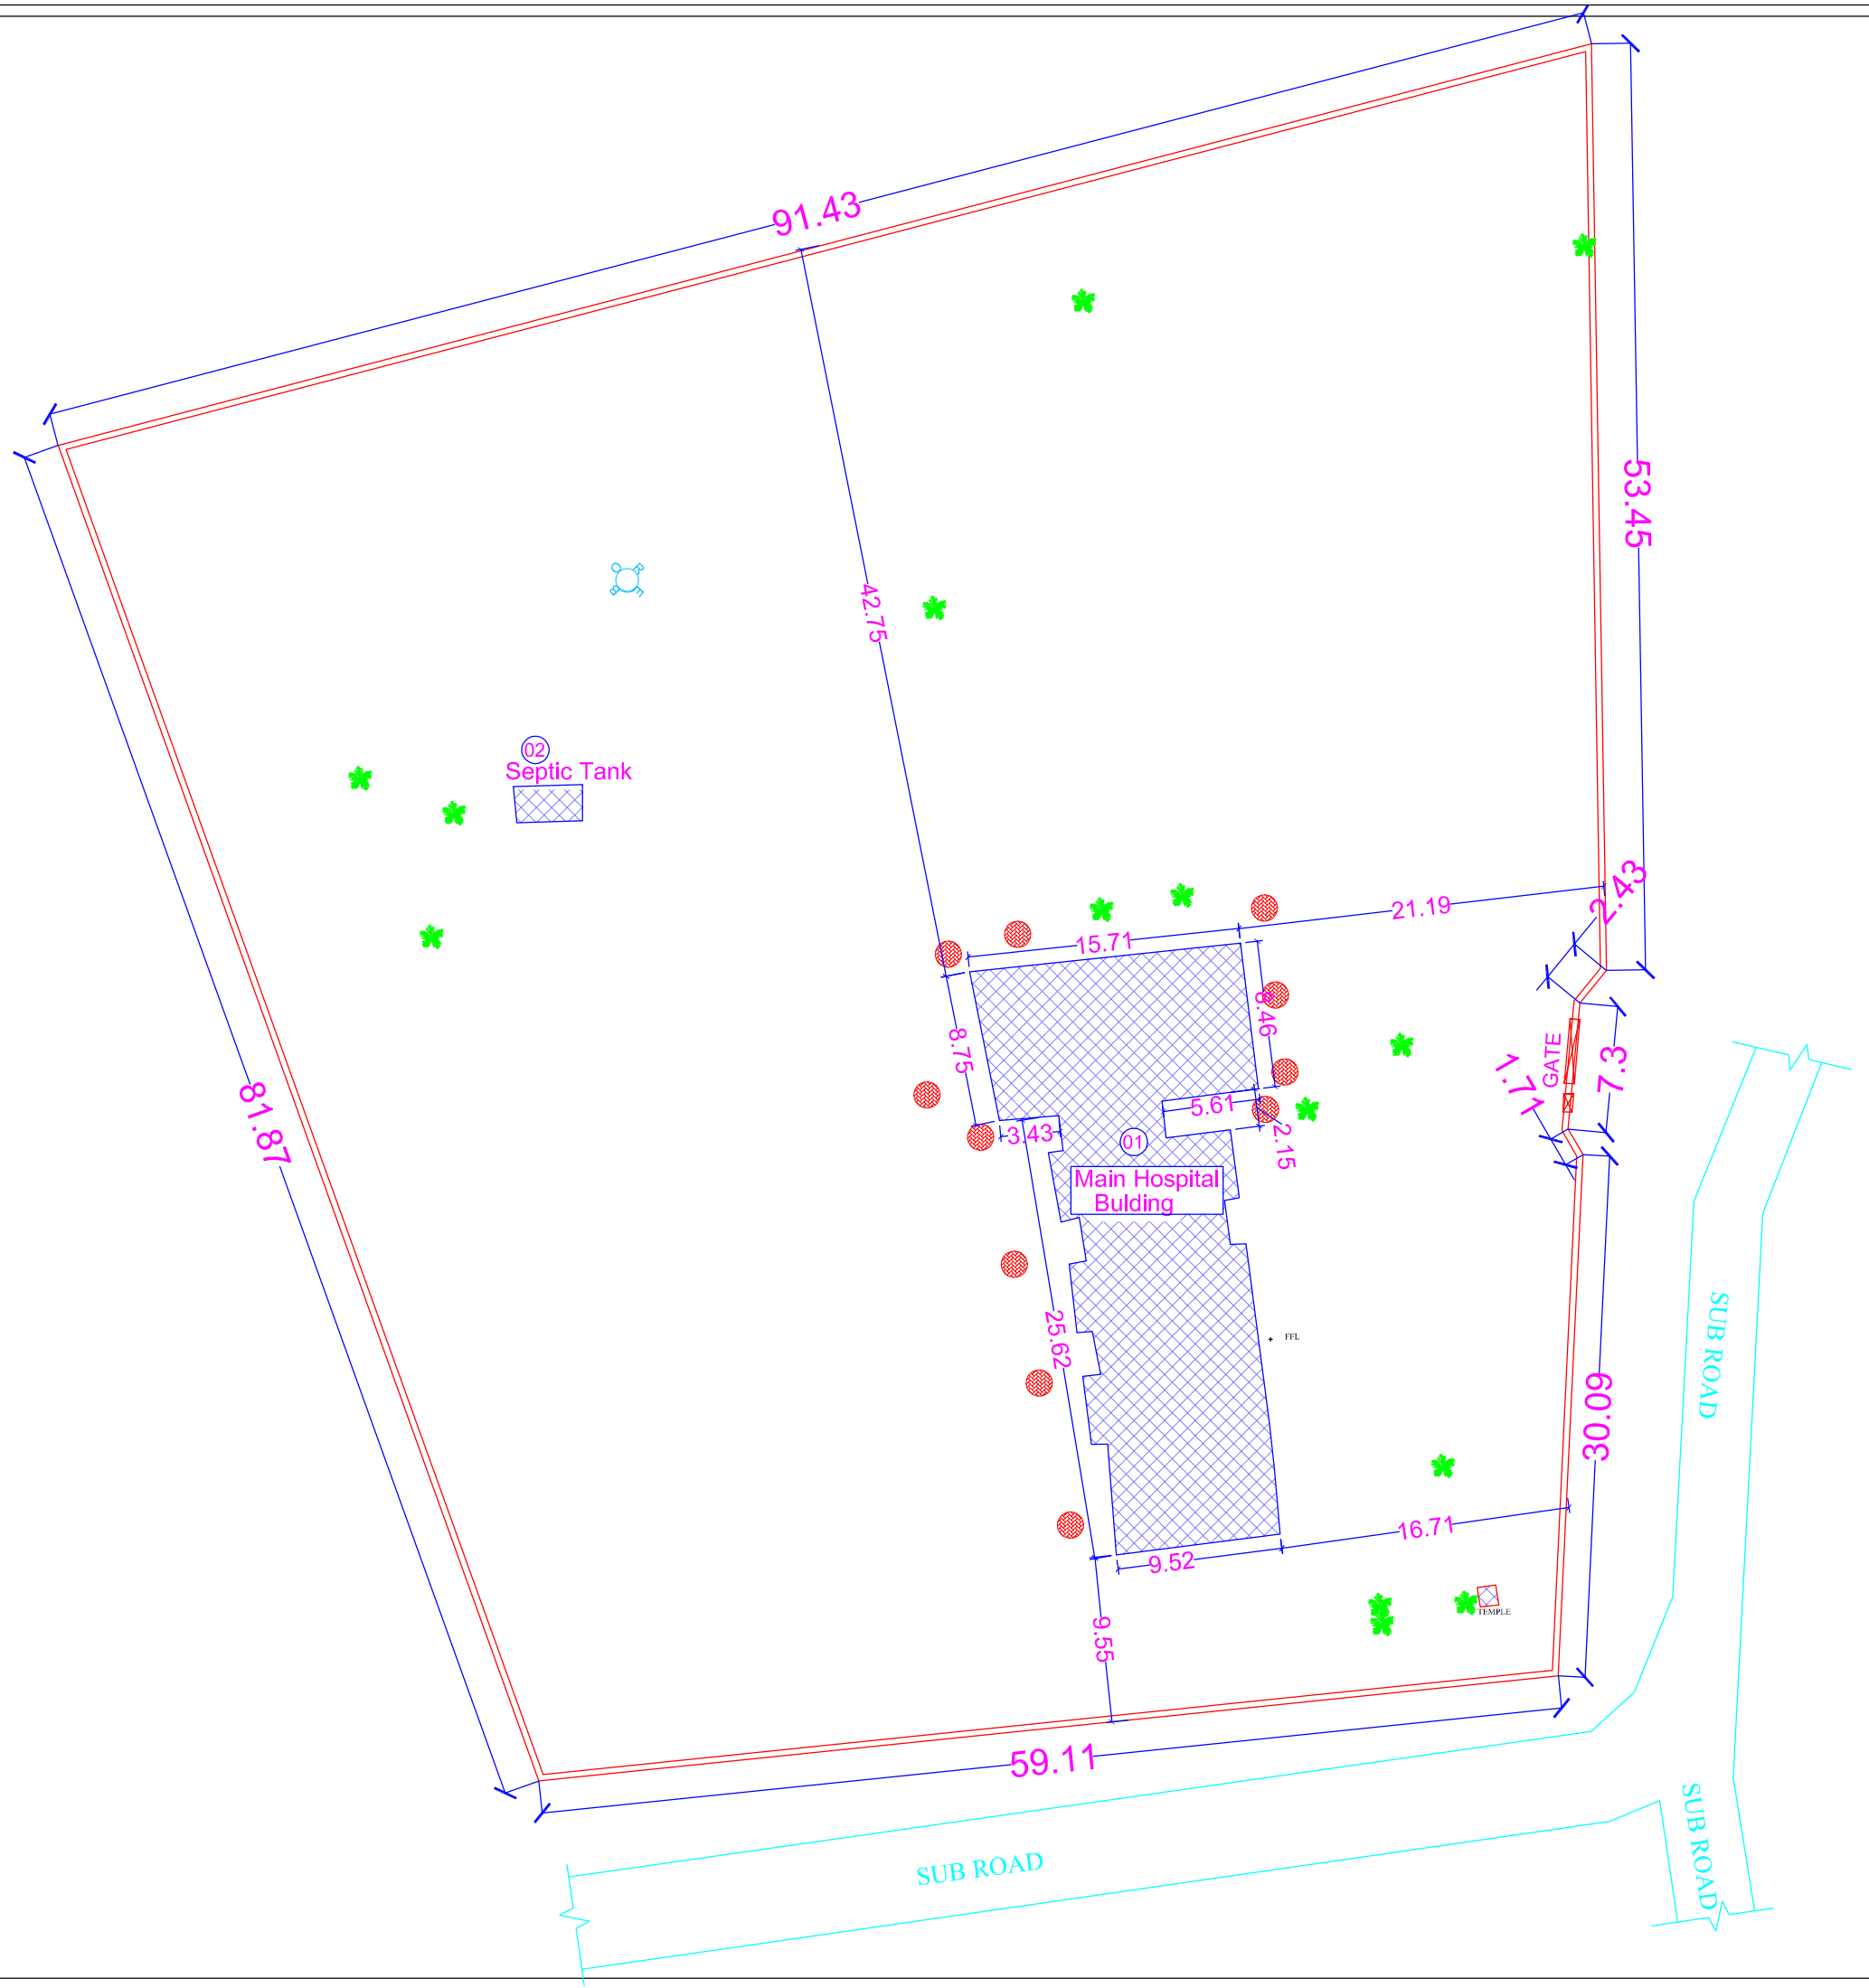

COPY RIGHT OF THIS DRAWING BELONGS TO M/S S.S.INFRASTRUCTURE AND SHOULD NOT BE USED FOR ANY PURPOSE OTHER THAN SPECIFIED WITHOUT PRIOR PERMISSION.

North :

N
W E
S

Legend :

TREES
BORE
MANHOLE
ELECTRICAL POLE
EXISTING ROAD
ST STATION POINT

Legend

S.NO.	NAME OF BLOCK	GROUND FLOOR AREA IN SQ.MTS.
1.	HOSPITAL MAIN BLOCK	345.08 Sqmts

TRUE COPY
Executive Engineer
T.S.M.S.I.D.C. DIVISION
NIZAMABAD.

AREAS :

8366.37 SQ.MTS
10006.1 SQ.YRD
2.067 Acres

PROJECT :

SURVEY PLAN AND ASSET MAPPING FOR HOSPITALS AND MEDICAL COLLEGES IN NIZAMABAD DISTRICT

TITLE :

PHC-JAKRANPALLY
SURVEYED SITE LAY-OUT

CLIENT :

TELANGANA STATE MEDICAL SERVICES
INFRASTRUCTURE DEVELOPMENT CORPORATION
(An Enterprise of Government of Telangana)
DM & HS CAMPUS
SULTAN BAZAR, KOTI, HYDERABAD.

CONSULTANTS :

S.S.INFRASTRUCTURE
PROJECT CONSULTANTS Pvt.Ltd.
25&9, JABBAR BUILDINGS,
BEGUMPET, HYDERABAD-16
Ph: +91 40 66310954, 66310240
FAX No: +91 40 66312949.
email: ssipcpl@gmail.com

DATE :	19-04-2016	SHEET NO:
SCALE :	N.T.S.	01
DEALT BY :	MOIN	
SURVEYOR :	B.V.RAMANA	
CHECKED BY :	SS RAO	

DRG.NO:- SSIPCPL / TSMSIDC / JAKRANPALLY / SURVEYED / SITE LAY-OUT / AD-01

COPY RIGHT OF THIS DRAWING BELONGS TO M/S S.S.INFRASTRUCTURE AND SHOULD NOT BE USED FOR ANY PURPOSE OTHER THAN SPECIFIED WITHOUT PRIOR PERMISSION.

North :

Legend :

TREES
BORE
MANHOLE
ELECTRICAL POLE
EXISTING ROAD
STATION POINT

Legend

S.NO.	NAME OF BLOCK	GROUND FLOOR AREA IN SQ.MTS.
1.	HOSPITAL MAIN BLOCK	345.08 Sqmts

TRUE COPY
Executive Engineer
T.S.M.S.I.D.C. DIVISION
NIZAMABAD.

AREAS :

8366.37 SQ.MTS
10006.1 SQ.YRD
2.067 Acres

PROJECT :

SURVEY PLAN AND ASSET MAPPING FOR HOSPITALS AND MEDICAL COLLEGES IN NIZAMABAD DISTRICT

TITLE :

PHC-JAKRANPALLY
SURVEYED SITE LAY-OUT

CLIENT :

TELANGANA STATE MEDICAL SERVICES
INFRASTRUCTURE DEVELOPMENT CORPORATION
(An Enterprise of Government of Telangana)
DM & HS CAMPUS
SULTAN BAZAR, KOTI, HYDERABAD.

CONSULTANTS :

S.S.INFRASTRUCTURE
PROJECT CONSULTANTS Pvt.Ltd.
25&9, JABBAR BUILDINGS,
BEGUMPET, HYDERABAD-16
Ph: +91 40 66310954, 66310240
FAX No: +91 40 66312949.
email: ssipcpl@gmail.com

DATE :	19-04-2016	SHEET NO:
SCALE :	N.T.S.	02
DEALT BY :	MOIN	
SURVEYOR :	B.V.RAMANA	
CHECKED BY :	SS RAO	

DRG.NO:- SSIPCPL / TSMSIDC / JAKRANPALLY / SURVEYED / SITE LAY-OUT / AD-02

91.43
53.45
42.75
81.87
59.11
30.00
25.62
21.19
15.71
8.75
9.46
5.61
2.15
3.43
9.52
9.55
16.71
2.43
3.3
1.71
GATE
Septic Tank
02
Main Hospital Bulding
01
FFL
TEMPLE
SUB ROAD
SUB ROAD
SUB ROAD
99.781 100.039 100.240 100.478 100.745 101.102
99.275 99.276 99.472 99.958 100.152 100.459 100.727 100.865 101.054
99.383 99.576 99.871 100.223 100.667 100.731 100.911 101.203
99.442 99.748 100.005 100.385 100.809 101.088 101.234 101.337 101.830
99.747 100.097 100.516 101.386 101.929 102.220
99.899 100.273 100.695 101.583 102.033 102.344
100.061 100.412 100.831 101.726 102.448
100.482 100.986 101.606 102.516 101.896 102.080 102.502
100.852 101.168 101.485 101.801 102.152 102.387 102.556