NAME OF THE WORK

SURVEY PLAN AND ASST MAPPING FOR HOSPITALS AND MEDICAL COLLEGES IN THE STATE OF TELANGANA

URBAN HEALTH CENTER AT SEETHARAMAGAR, NIZAMABAD DISTRICT

CLIENT:

TSMSIDC, 2nd floor, DM & HS Campus,
Sultan Bazar, Koti, Hyderabad-500095.

CONSULTANTS

S.S.INFRASTRUCTURE
PROJECT CONSULTANTS Pvt.Ltd.
ISO 9001-2008 Certified
#25 & 9, Jabbar Buildings
Begumpet, Hyderabad- 500 016
Phone: +91 40 66310954, 66310240
Fax: +91 40 66312949, Email: ssipcpl@gmail.com

URBAN HEALTH CENTERS AT SEETHARAMNAGAR, NIZAMABAD DISTRICT

EXTENT OF AREA	:	**417.75 SQ.YDS (OR) 0.0863ACRES**
BUILT-UP AREA	:	
HOSPITAL MAIN BLOCK	:	**179.46 SQ.MT (OR) 1931.70 SFT**
TYPE OF BUILDING	:	
HOSPITAL MAIN BLOCK	:	**RCC FRAMED STRUCTURE COVERED RCC ROOF SLAB**
NO OF FLOORS	:	
HOSPITAL MAIN BLOCK	:	**GROUND FLOOR**

URBAN HEALTH CENTER AT SEETHARAM NAGAR

ENTRANCE GATE

ENTRANCE

OUT PATIENT WAITING HALL

MEDICAL OFFICER ROOM

STAFF NURSE ROOM

IMMUNIZATION O.P

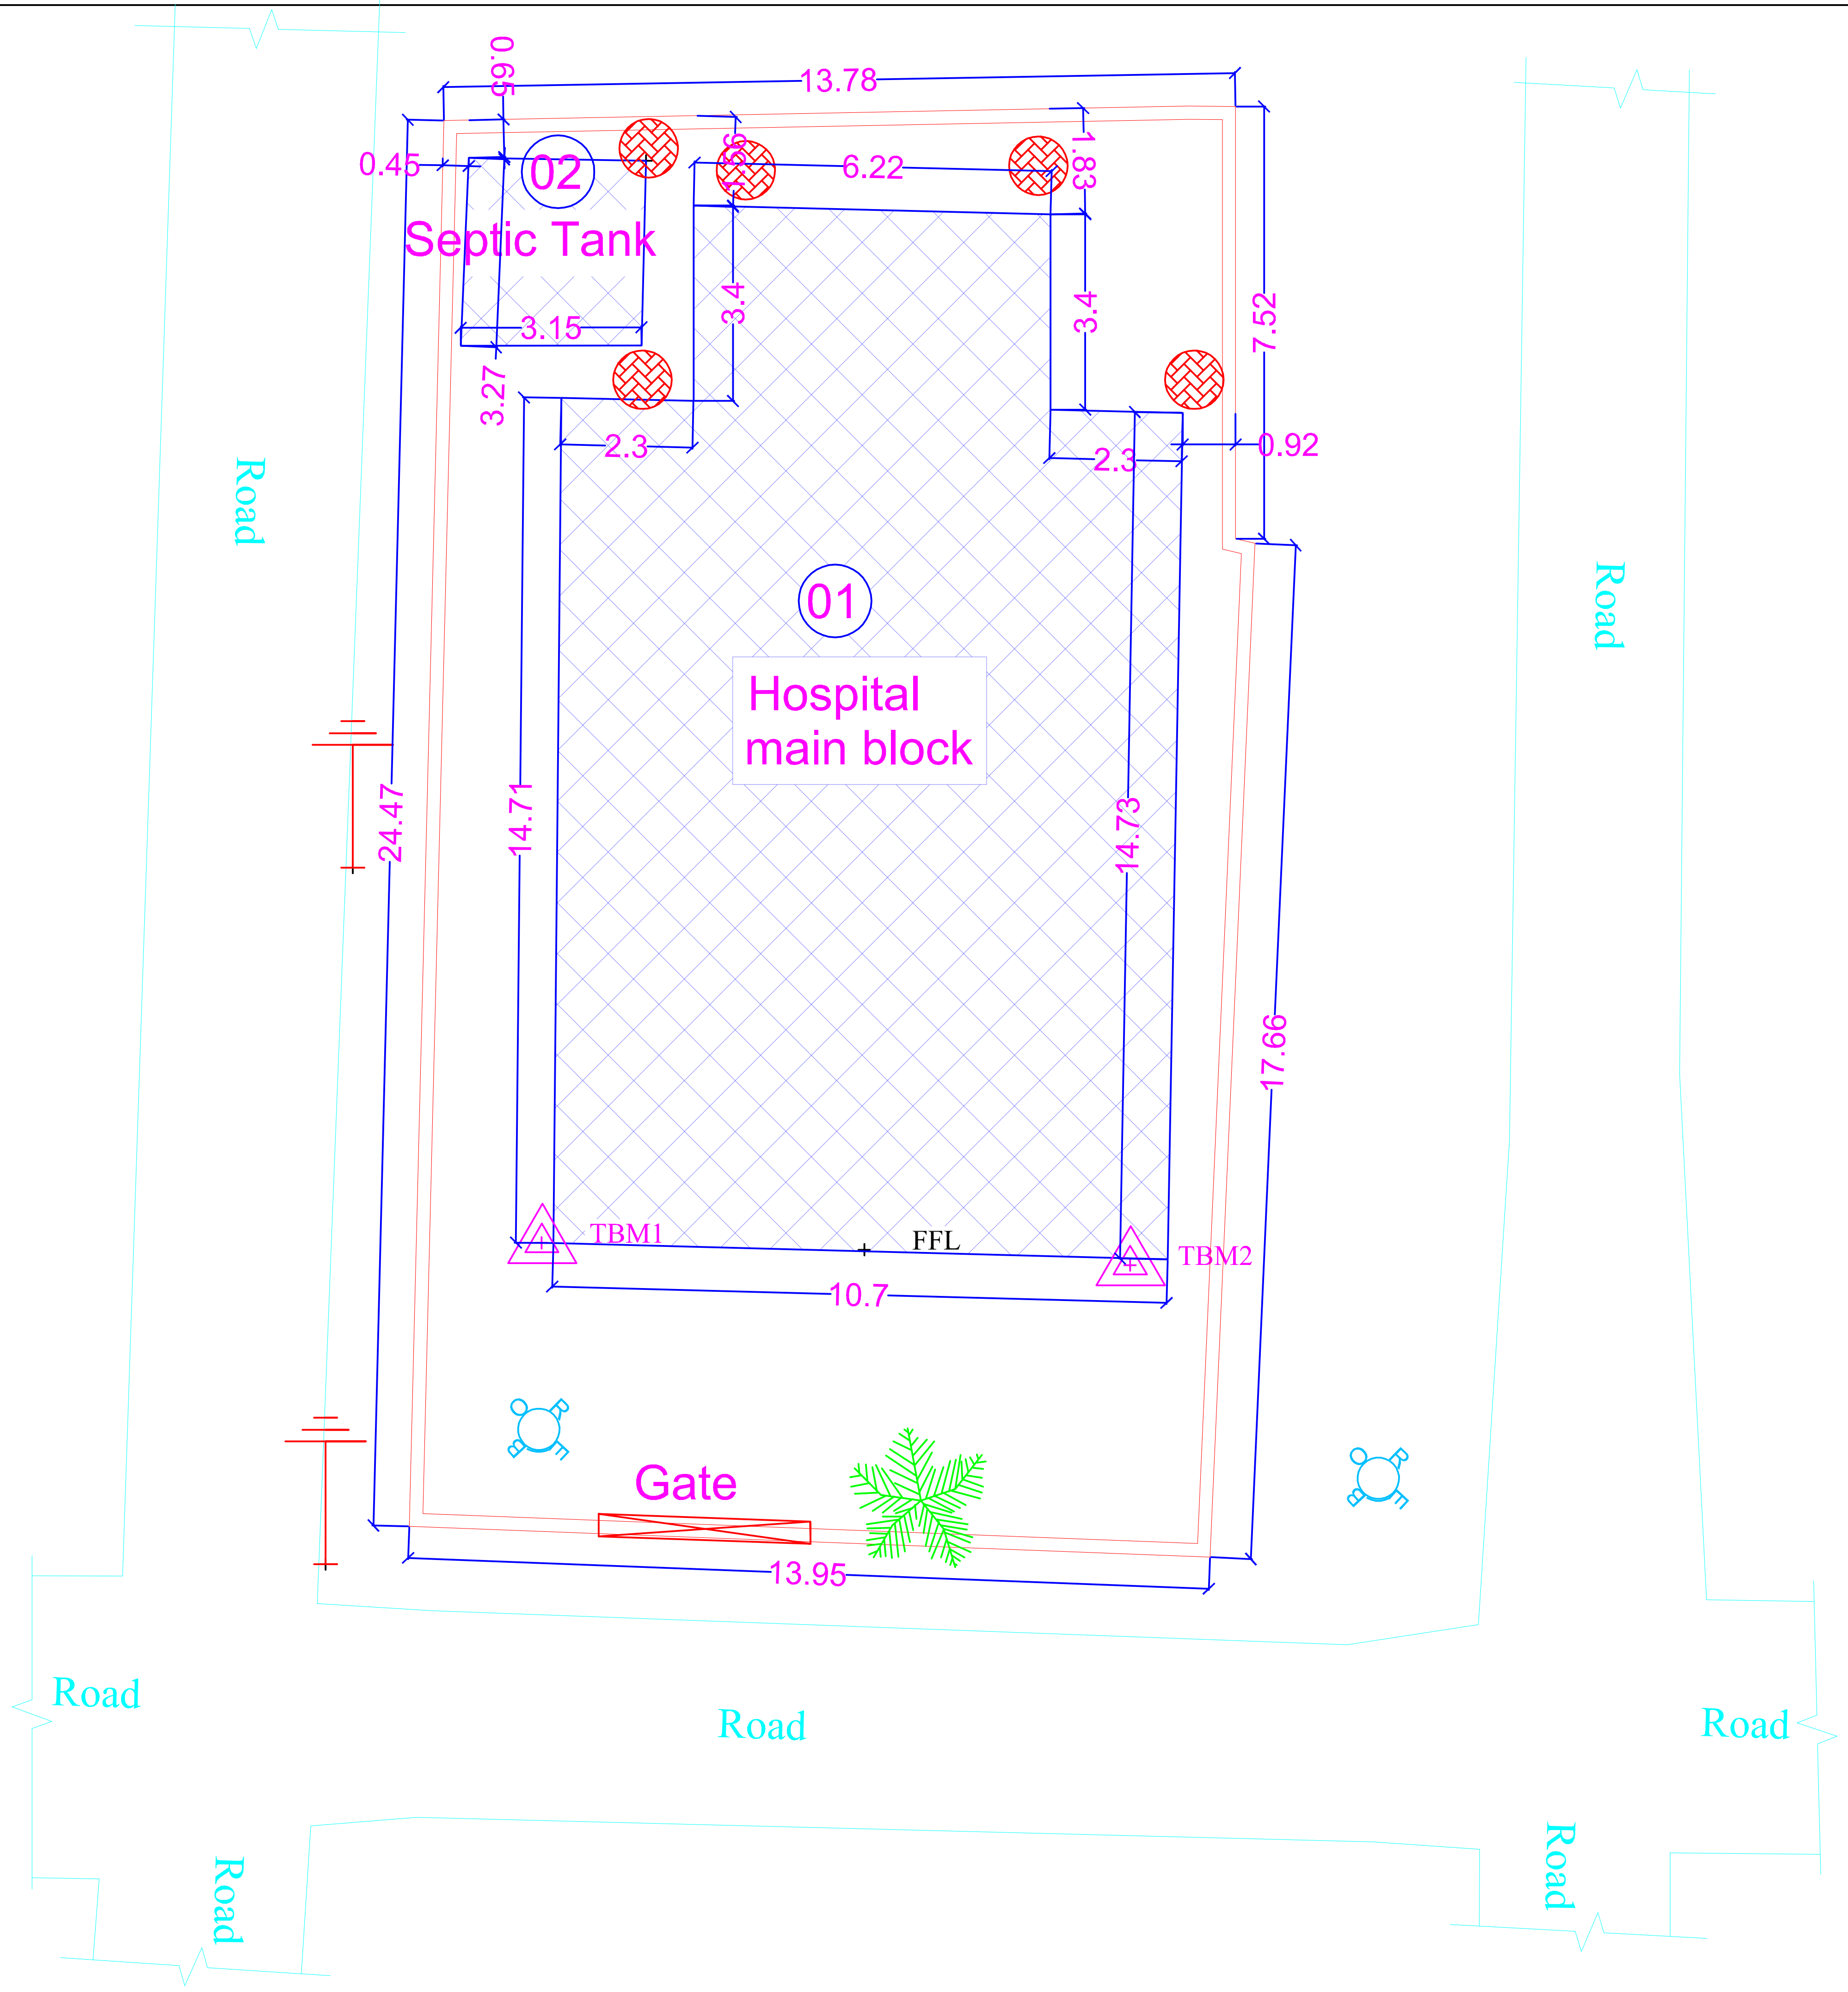

COPY RIGHT OF THIS DRAWING BELONGS TO M/S S.S.INFRASTRUCTURE AND SHOULD NOT BE USED FOR ANY PURPOSE OTHER THAN SPECIFIED WITHOUT PRIOR PERMISSION.

North :

S E W N

Legend :

TREES
BORE
MANHOLE
ELECTRICAL POLE
EXISTING ROAD
ST STATION POINT

Legend

S.NO.	NAME OF BLOCK	TOTAL FLOOR WISE AREAS IN SQ.MTS.		
		STAGE	GROUND FLOOR	AREA
1.	HOSPITAL MAIN BLOCK	EXISTING	179.46	183.03
2.	SEPTIC TANK	EXISTING	-	-

AREAS :

349.30 SQ.MTS
417.75 SQ.YRD
0.0863 Acres

PROJECT :

EXISTING URBAN HEALTH CENTRE
AT SITARAM NAGAR,
NIZAMABAD DIST.

TITLE :

SURVEYED SITE LAY-OUT

CLIENT :

TELANGANA STATE MEDICAL SERVICES
INFRASTRUCTURE DEVELOPMENT CORPORATION
(An Enterprise of Government of Telangana)
DM & HS CAMPUS
SULTAN BAZAR, KOTI, HYDERABAD.

CONSULTANTS :

S.S.INFRASTRUCTURE
PROJECT CONSULTANTS Pvt.Ltd.
25&9, JABBAR BUILDINGS,
BEGUMPET, HYDERABAD-16
Ph: +91 40 66310954, 66310240
FAX No: +91 40 66312949.
email: ssipcpl@gmail.com

DATE :	09-05-2016	SHEET NO:
SCALE :	N.T.S.	01
DEALT BY :	MOIN	
SURVEYOR :	B.V.RAMANA	
CHECKED BY :		

DRG.NO:- SS / TSMSIDC / SITARAM NAGAR / SURVEYED SITE LAY-OUT / AD-01

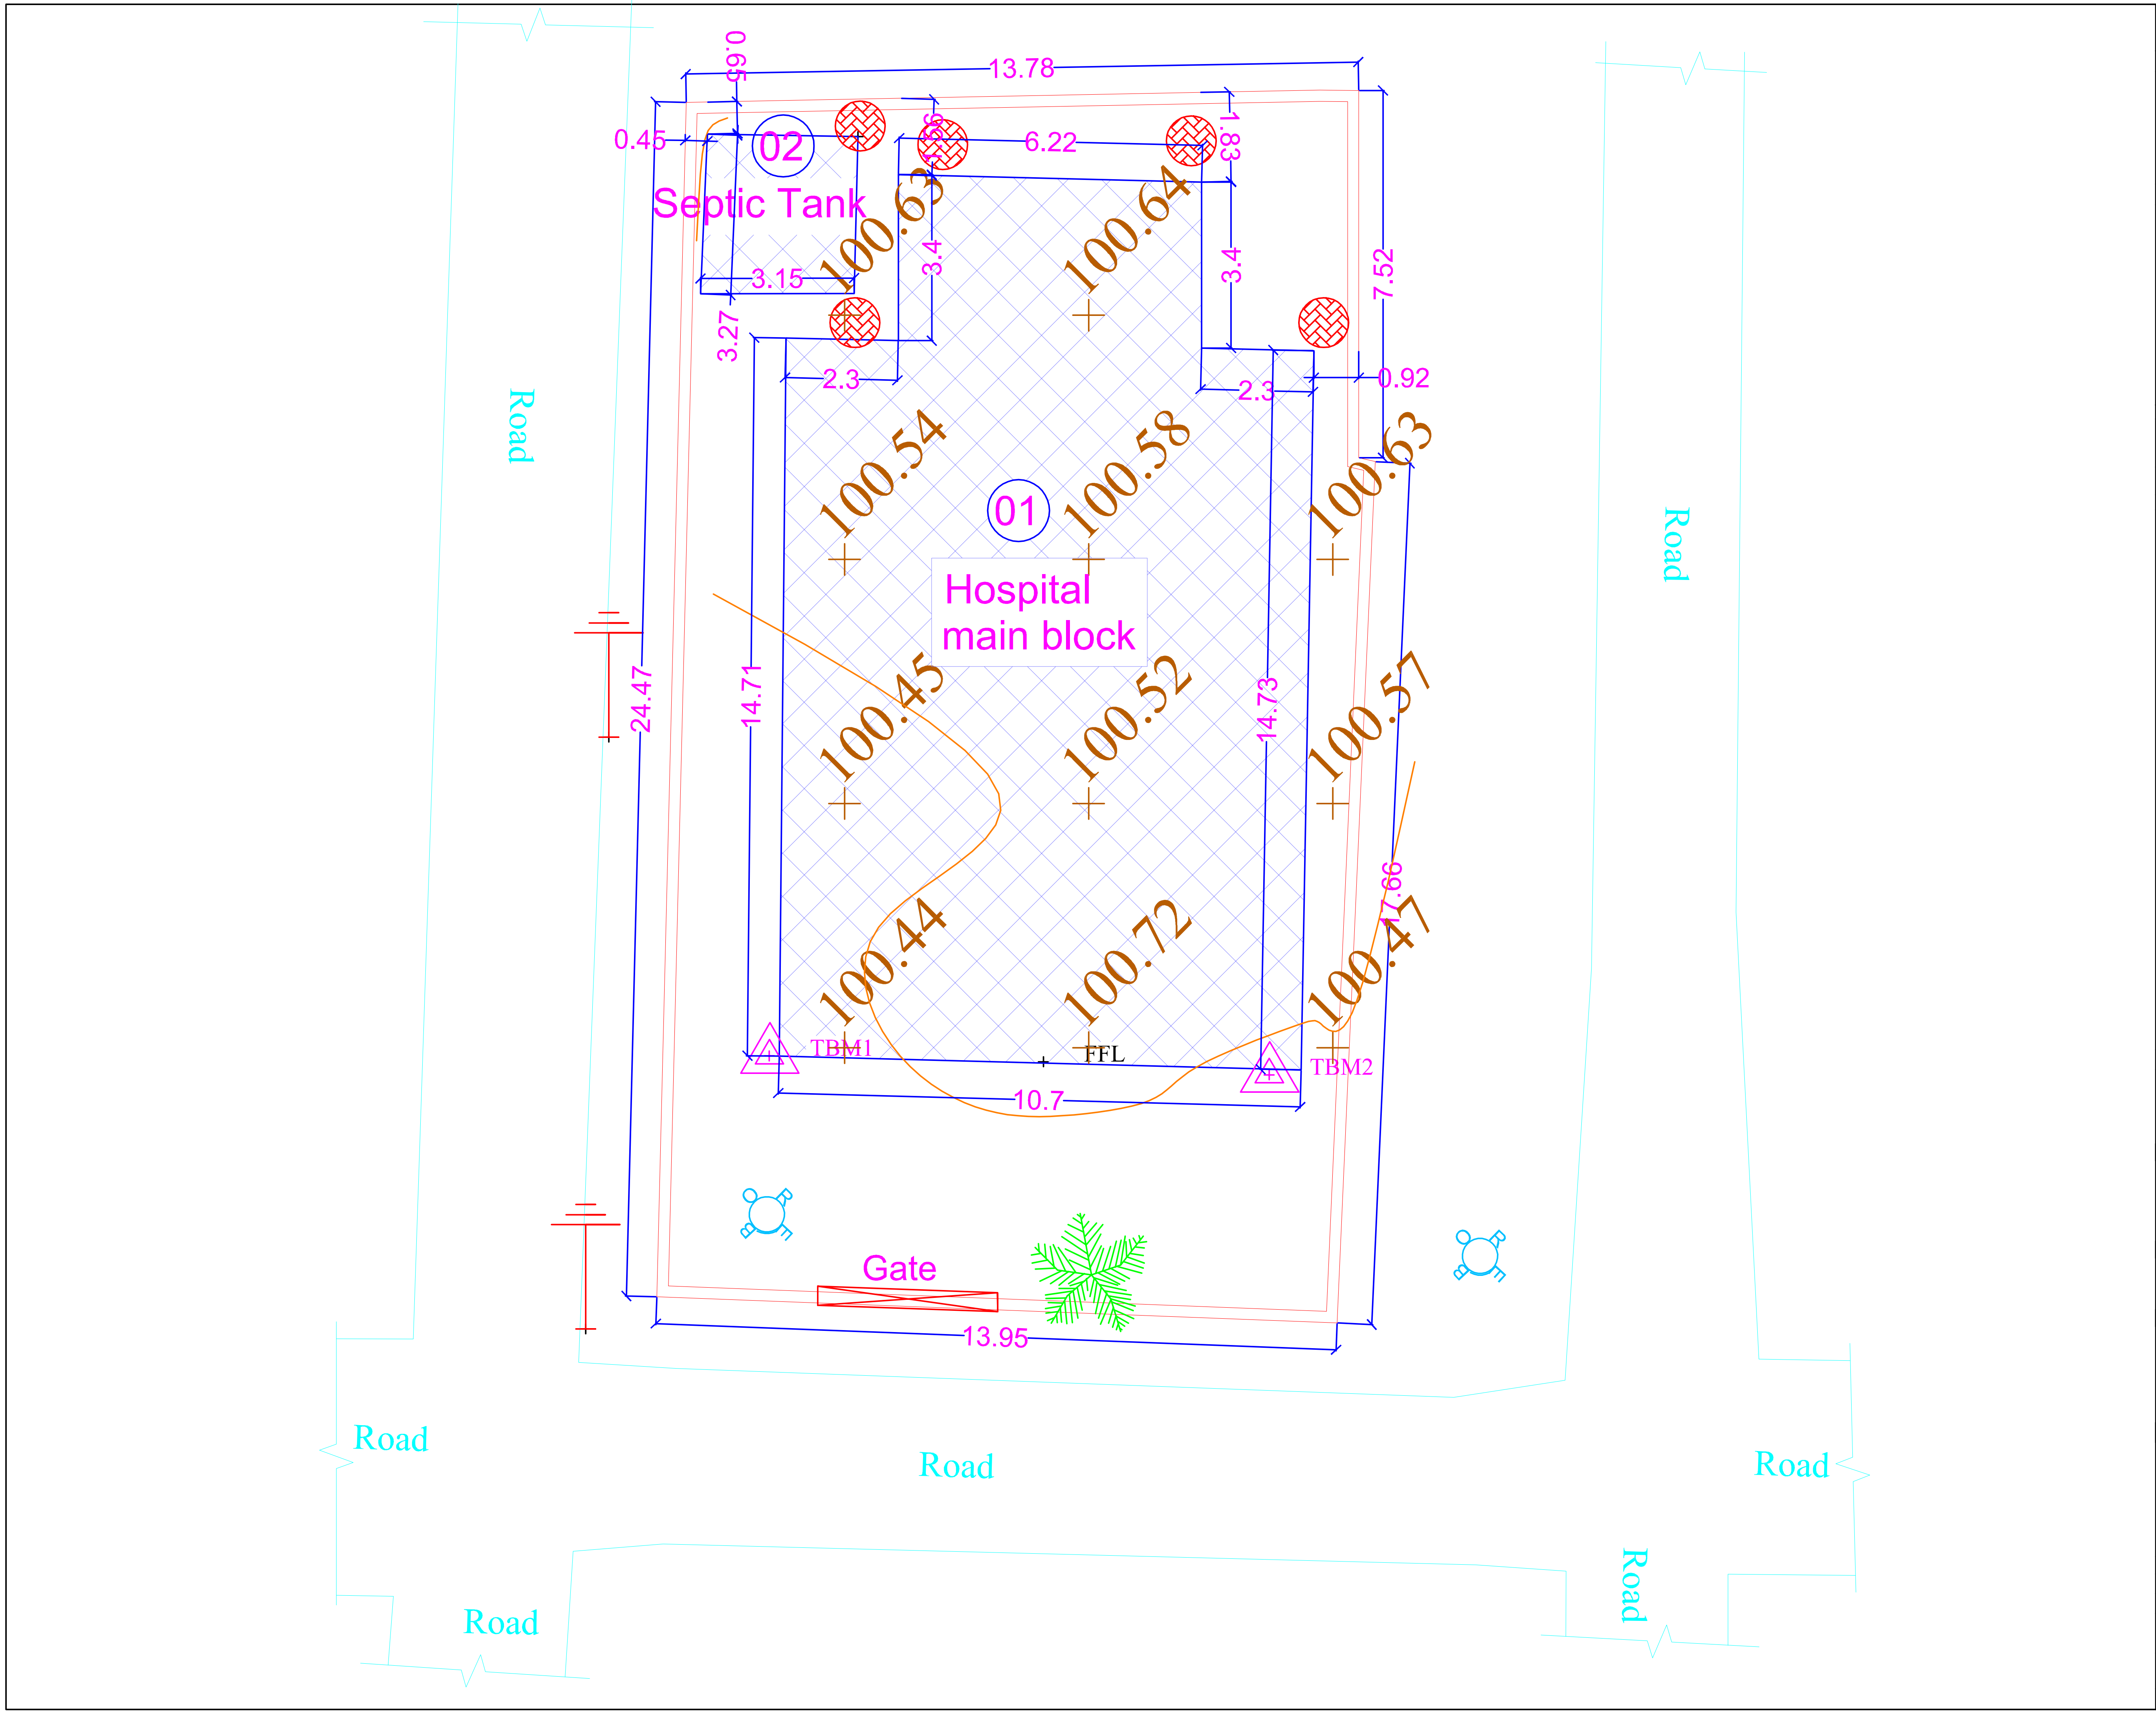

COPY RIGHT OF THIS DRAWING BELONGS TO M/S S.S.INFRASTRUCTURE AND SHOULD NOT BE USED FOR ANY PURPOSE OTHER THAN SPECIFIED WITHOUT PRIOR PERMISSION.

North :

Legend :

- TREES
- BORE
- MANHOLE
- ELECTRICAL POLE
- EXISTING ROAD
- ST STATION POINT

Legend

S.NO.	NAME OF BLOCK	TOTAL FLOOR WISE AREAS IN SQ.MTS.		
		STAGE	GROUND FLOOR	AREA
1.	HOSPITAL MAIN BLOCK	EXISTING	179.46	183.03
2.	SEPTIC TANK	EXISTING	-	-

AREAS :

349.30 SQ.MTS
417.75 SQ.YRD
0.0863 Acres

PROJECT :

EXISTING URBAN HEALTH CENTRE
AT SITARAM NAGAR,
NIZAMABAD DIST.

TITLE :

SURVEYED SITE LAY-OUT

CLIENT :

TELANGANA STATE MEDICAL SERVICES
INFRASTRUCTURE DEVELOPMENT CORPORATION
(An Enterprise of Government of Telangana)
DM & HS CAMPUS
SULTAN BAZAR, KOTI, HYDERABAD.

CONSULTANTS :

S.S.INFRASTRUCTURE
PROJECT CONSULTANTS Pvt.Ltd.
25&9, JABBAR BUILDINGS,
BEGUMPET, HYDERABAD-16
Ph: +91 40 66310954, 66310240
FAX No: +91 40 66312949,
email: ssipcpl@gmail.com

DATE :	09-05-2016	SHEET NO:
SCALE :	N.T.S.	02
DEALT BY :	MOIN	
SURVEYOR :	B.V.RAMANA	
CHECKED BY :		

DRG.NO:- SS / TSMSIDC / SITARAM NAGAR / SURVEYED SITE LAY-OUT / AD-02

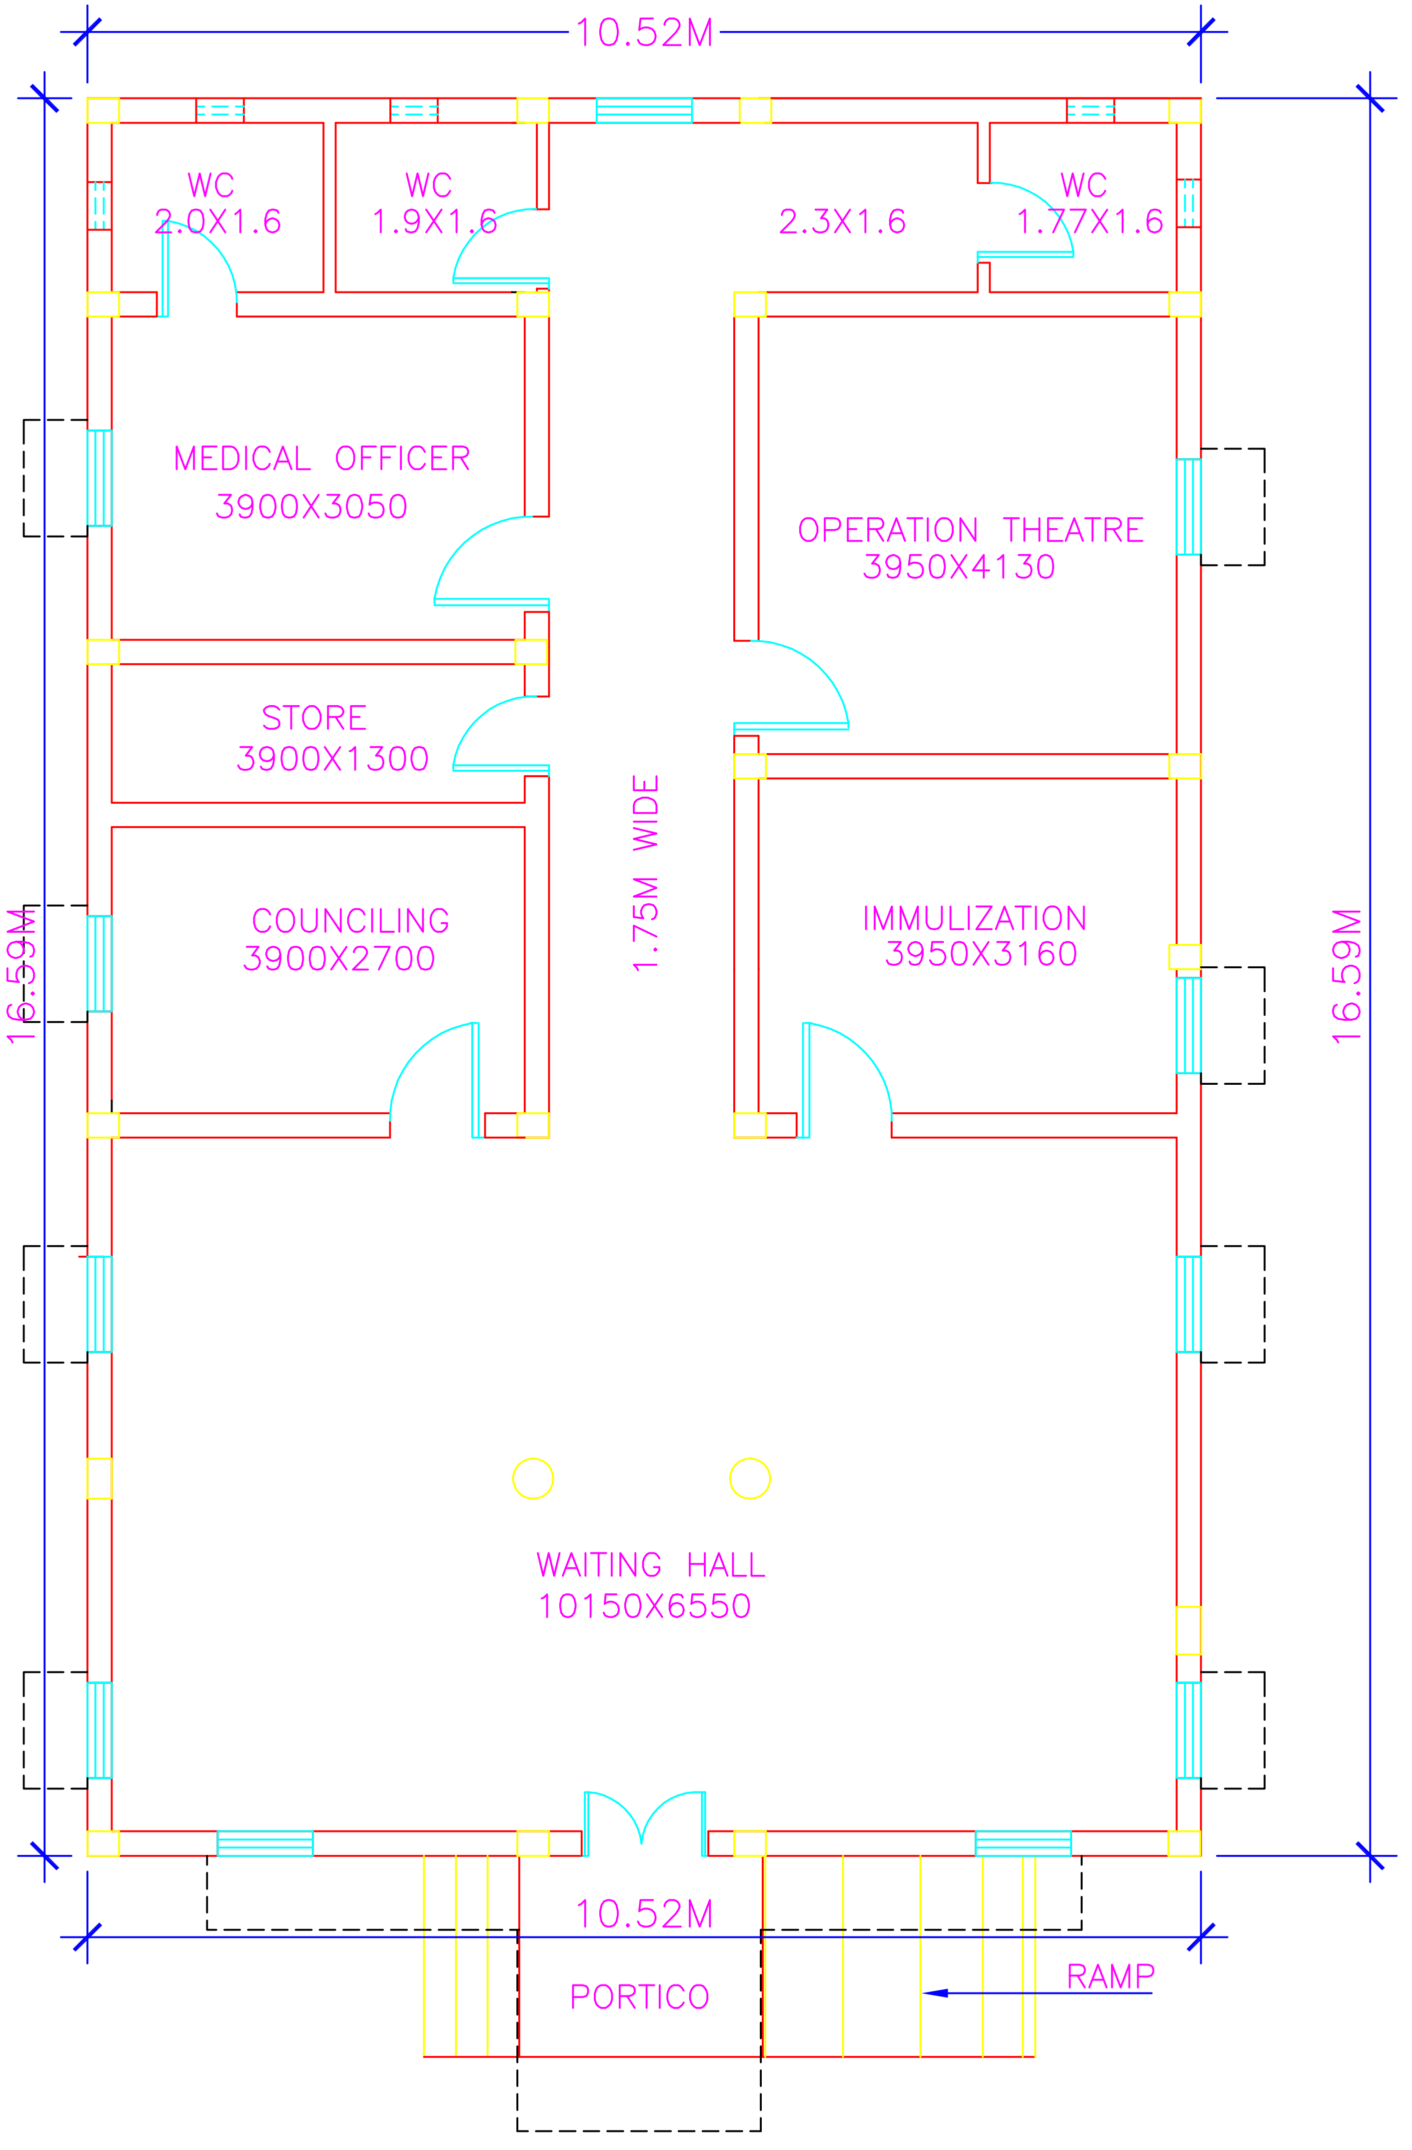

COPY RIGHT OF THIS DRAWING BELONGS TO M/S S.S.INFRASTRUCTURE AND SHOULD NOT BE USED FOR ANY PURPOSE OTHER THAN SPECIFIED WITHOUT PRIOR PERMISSION.

North :

N E W S

AS BUILT DRAWING

Area:

GROUND FLOOR BUILDING	174.52 Sqmts
TOTAL	174.52 Sqmts
PORTICO	10.15 Sqmts

STATUS :

EXISTING BUILDING

PROJECT :

URBAN HEALTH CENTRE AT
AT SITARAM NAGAR,
NIZAMABAD DISTRICT.

TITLE :

HOSPITAL BUILDING
GROUND FLOOR PLAN

CLIENT :

TELANGANA STATE MEDICAL SERVICES
INFRASTRUCTURE DEVELOPMENT CORPORATION
(An Enterprise of Government of Telangana)
DM & HS CAMPUS
SULTAN BAZAR, KOTI, HYDERABAD.

CONSULTANTS :

S.S.INFRASTRUCTURE
PROJECT CONSULTANTS Pvt.Ltd.
25&9, JABBAR BUILDINGS,
BEGUMPET, HYDERABAD-16
Ph: +91 40 66310954, 66310240
FAX No: +91 40 66312949.
email: ssipcpl@gmail.com

DATE :	07-06-2016	SHEET NO:
SCALE :	N.T.S.	03
DEALT BY :	PAVAN	
SURVEYOR :	B.V.RAMANA	
CHECKED BY :		

DRG.NO:- SS / TSMSIDC/ SITARAM NAGAR / HOSPITAL BUILDING/ AD-03