NAME OF THE WORK

SURVEY PLAN AND ASSET MAPPING FOR HOSPITALS AND MEDICAL COLLEGES IN THE STATE OF TELANGANA

PRIMARY HEALTH CENTRE AT DUGGONDI, WARANGAL DISTRICT

CLIENT:

TSMSIDC, 2nd floor, DM & HS Campus,
Sultan Bazar, Koti, Hyderabad-500095.

CONSULTANTS:

ARCHITECTS
INTERIOR
DESIGNERS

375, Road No.10, Jubilee Hills,
Hyderabad -500034, A.P., India
Ph: 04023553510
e-mail: office@mkteam.in

PRIMARY HEALTH CENTRE AT DUGGONDI, WARANGAL DISTRICT

EXTENT OF AREA	:	**7995.55 SQ.YDS (OR) 1.65 ACRES**
BUILT-UP AREA	:	
HOSPITAL MAIN BLOCK	:	**177.16 SQ.MT (OR) 1906.93 SFT**
OT BOCK	:	**75.26 SQ.MT (OR) 810.09 SFT**
CHO OFFICE	:	**107.60 SQ.MT (OR) 1158.19 SFT**
TYPE OF BUILDING	:	
HOSPITAL MAIN BLOCK	:	**LOAD BEARING STRUCTURE COVERED RCC ROOF SLAB**
OT BOCK	:	**LOAD BEARING STRUCTURE COVERED RCC ROOF SLAB**
CHO OFFICE	:	**LOAD BEARING STRUCTURE COVERED RCC ROOF SLAB**
NO OF FLOORS	:	
HOSPITAL MAIN BLOCK	:	**GROUND FLOOR**
OT BOCK	:	**GROUND FLOOR**
CHO OFFICE	:	**GROUND FLOOR**

PRIMARY HEALTH CENTRE AT DUGGONDI

FRONT VIEW

MEDICAL OFFICER

VACCINE STORE

GENERAL WARD

MEDICAL STORE

LABOUR ROOM

OLD QUARTERS

OLD QUARTER

GOVT HOMEO BUILDING

COPY RIGHT OF THIS DRAWING BELONGS TO M/S. M.K.TEAM
AND SHOULD NOT BE USED FOR ANY PURPOSE OTHER THAN SPECIFIED
WITHOUT PRIOR PERMISSION.

North :

Legend :

OTHER TREE

BORE

MANHOLE

ELECTRICAL POLE

EXISTING ROAD

STATION POINT

Legend

S.NO.	NAME OF BLOCK	STAGE	GROUND FLOOR	AREA
1.	HOSPITAL MAIN BLOCK	EXISTING	183.77	183.77
2.	OPERATION THEATER	EXISTING	70.33	70.33
3.	METING HALL	EXISTING	52.61	52.61
4.	AYSHU BLOCK	EXISTING	115.00	115.00
5.	OFFICE	EXISTING	95.43	95.43
6.	OLD BLOCK	EXISTING	-	-
7.	SUMP	EXISTING	-	-
8.	SEPTIC TANK	EXISTING	-	-
9.	PIEZO METER	EXISTING	-	-

AREAS :

6792.28 SQ.MTS
8123.49 SQ.YRD
1.67 Acres

PROJECT :

SURVEY PLAN AND ASSET MAPPING
FOR HOSPITALS AND MEDICAL COLLEGES
IN WARANGAL DISTRICT

TITLE :

PHC-DUGGONDI
SURVEYED SITE LAY-OUT

CLIENT :

TELANGANA STATE MEDICAL SERVICES
INFRASTRUCTURE DEVELOPMENT CORPORATION
(An Enterprise of Government of Telangana)
DM & HS CAMPUS
SULTAN BAZAR, KOTI, HYDERABAD.

CONSULTANTS :

ARCHITECTS
INTERIOR
DESIGNERS
375, Road No.10, Jubilee Hills,
Hyderabad-500034.
Ph: 04023553510
e-mail: office@mkteam.in

DATE :	03-09-2016	SHEET NO:
SCALE :	N.T.S.	01
DEALT BY :	TARA KRISHNA	
SURVEYOR :	B.V.RAMANA	
CHECKED BY :	K.MURALI	

DRG.NO:- MK / TSMSIDC / DUGGONDI /
SURVEYED SITE LAY-OUT / AD-01

COPY RIGHT OF THIS DRAWING BELONGS TO M/S. M.K.TEAM
AND SHOULD NOT BE USED FOR ANY PURPOSE OTHER THAN SPECIFIED
WITHOUT PRIOR PERMISSION.

North :

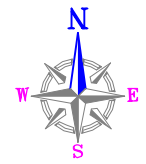

Legend :

OTHER TREE

BORE

MANHOLE

ELECTRICAL POLE

EXISTING ROAD

STATION POINT

Legend

S.NO.	NAME OF BLOCK	STAGE	GROUND FLOOR	AREA
1.	HOSPITAL MAIN BLOCK	EXISTING	183.77	183.77
2.	OPERATION THEATER	EXISTING	70.33	70.33
3.	METING HALL	EXISTING	52.61	52.61
4.	AYSHU BLOCK	EXISTING	115.00	115.00
5.	OFFICE	EXISTING	95.43	95.43
6.	OLD BLOCK	EXISTING	-	-
7.	SUMP	EXISTING	-	-
8.	SEPTIC TANK	EXISTING	-	-
9.	PIEZO MEASURE	EXISTING	-	-

AREAS :

6792.28 SQ.MTS
8123.49 SQ.YRD
1.67 Acres

PROJECT :

SURVEY PLAN AND ASSET MAPPING
FOR HOSPITALS AND MEDICAL COLLEGES
IN WARANGAL DISTRICT

TITLE :

PHC-DUGGONDI
SURVEYED SITE LAY-OUT

CLIENT :

TELANGANA STATE MEDICAL SERVICES
INFRASTRUCTURE DEVELOPMENT CORPORATION
(An Enterprise of Government of Telangana)
DM & HS CAMPUS
SULTAN BAZAR, KOTI, HYDERABAD.

CONSULTANTS :

MK team
ARCHITECTS
INTERIOR
DESIGNERS
375, Road No.10, Jubilee Hills,
Hyderabad-500034.
Ph: 04023553510
e-mail: office@mkteam.in

DATE :	03-09-2016	SHEET NO:
SCALE :	N.T.S.	02
DEALT BY :	TARA KRISHNA	
SURVEYOR :	B.V.RAMANA	
CHECKED BY :	K.MURALI	

DRG.NO:- MK / TSMSIDC / DUGGONDI /
SURVEYED SITE LAY-OUT / AD-02

COPY RIGHT OF THIS DRAWING BELONGS TO M/S MK TEAM AND SHOULD NOT BE USED FOR ANY PURPOSE OTHER THAN SPECIFIED WITHOUT PRIOR PERMISSION.

North :

AS BUILT DRAWING

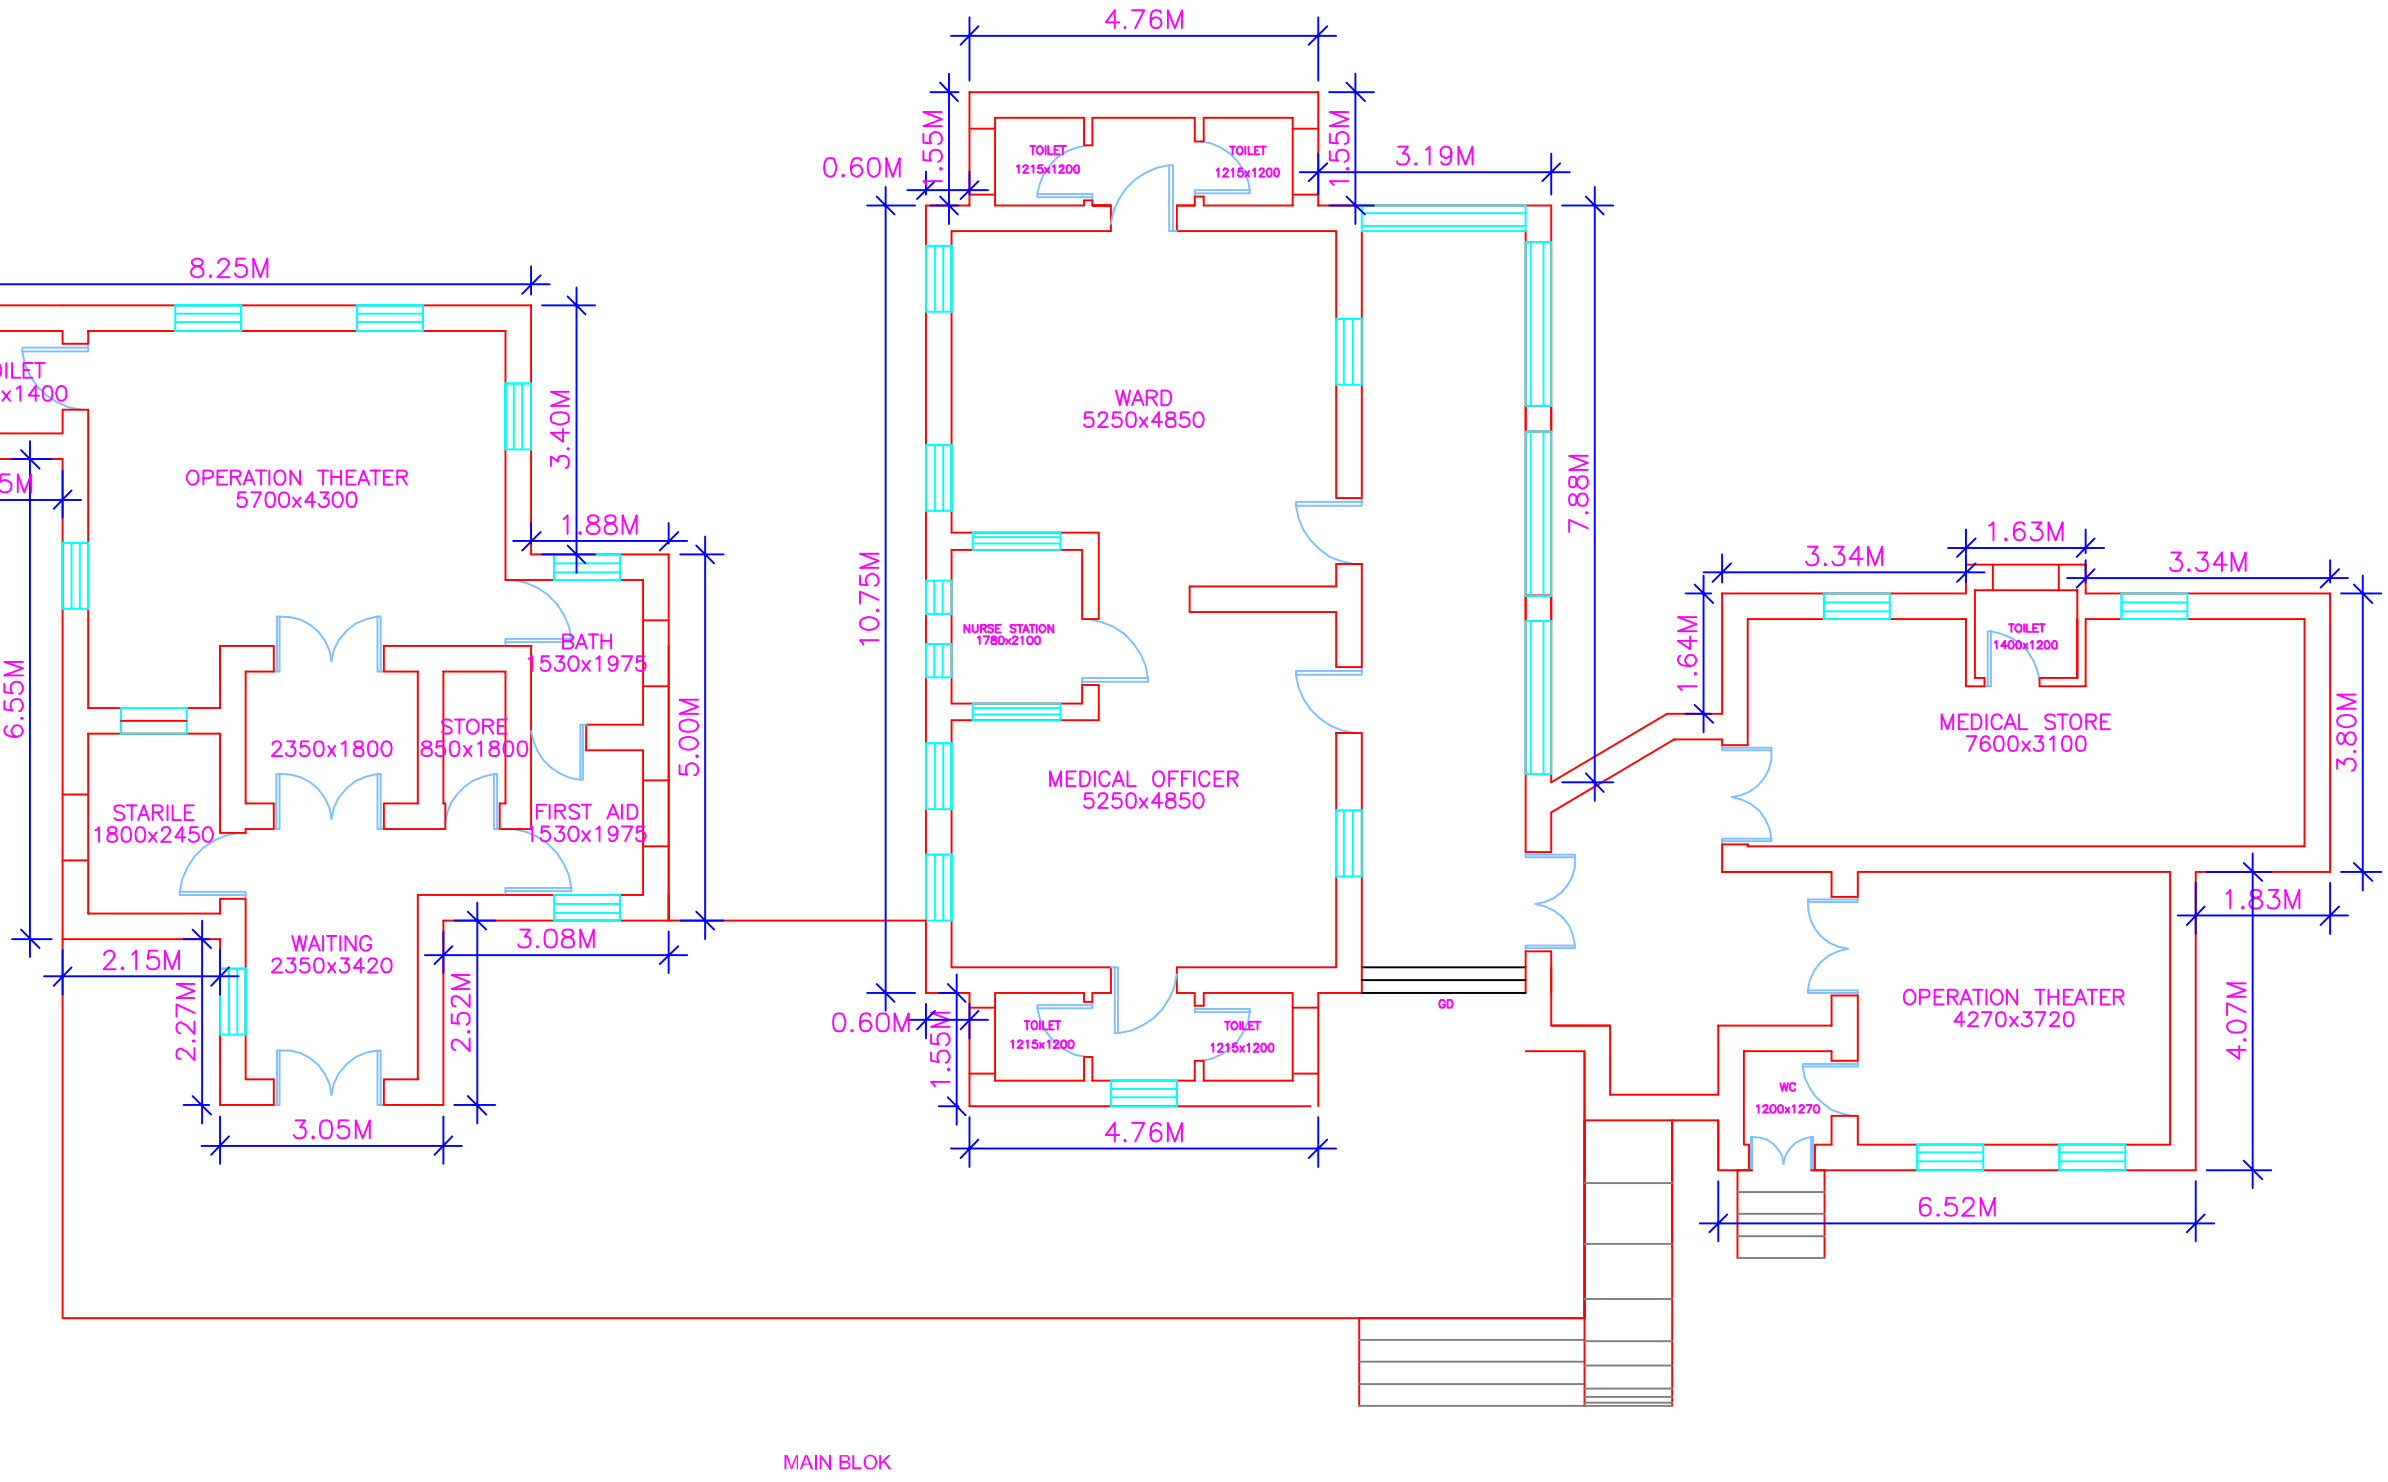

MAIN BLOK

Area:

MAIN BLOCK	177.16 SQMTS
O.T BLOCK	75.26 SQMTS
TOTAL	252.42 SQMTS

STATUS :

EXISTING BUILDING

PROJECT :

SURVEY PLAN AND ASSET MAPPING FOR HOSPITALS AND MEDICAL COLLEGES IN WARANGAL DISTRICT

TITLE :

PHC-DUGGONDI
FLOOR PLAN

CLIENT :

TELANGANA STATE MEDICAL SERVICES
INFRASTRUCTURE DEVELOPMENT CORPORATION
(An Enterprise of Government of Telangana)
DM & HS CAMPUS
SULTAN BAZAR, KOTI, HYDERABAD.

CONSULTANTS :

mk team
ARCHITECTS
INTERIOR
DESIGNERS
375, Road No.10, Jubilee Hills,
Hyderabad-500034.
Ph: 04023553510
e-mail: office@mkteam.in

DATE :	15-07-2016	SHEET NO:
SCALE :	N.T.S.	03
DEALT BY :	B.PAVAN	
SURVEYOR :	B.V.RAMANA	
CHECKED BY :	K.MURALI	

DRG.NO:- MKT / TSMSIDC /DUGGONDI/ MAIN BLOCK / AD-03

COPY RIGHT OF THIS DRAWING BELONGS TO M/S MK TEAM AND SHOULD NOT BE USED FOR ANY PURPOSE OTHER THAN SPECIFIED WITHOUT PRIOR PERMISSION.

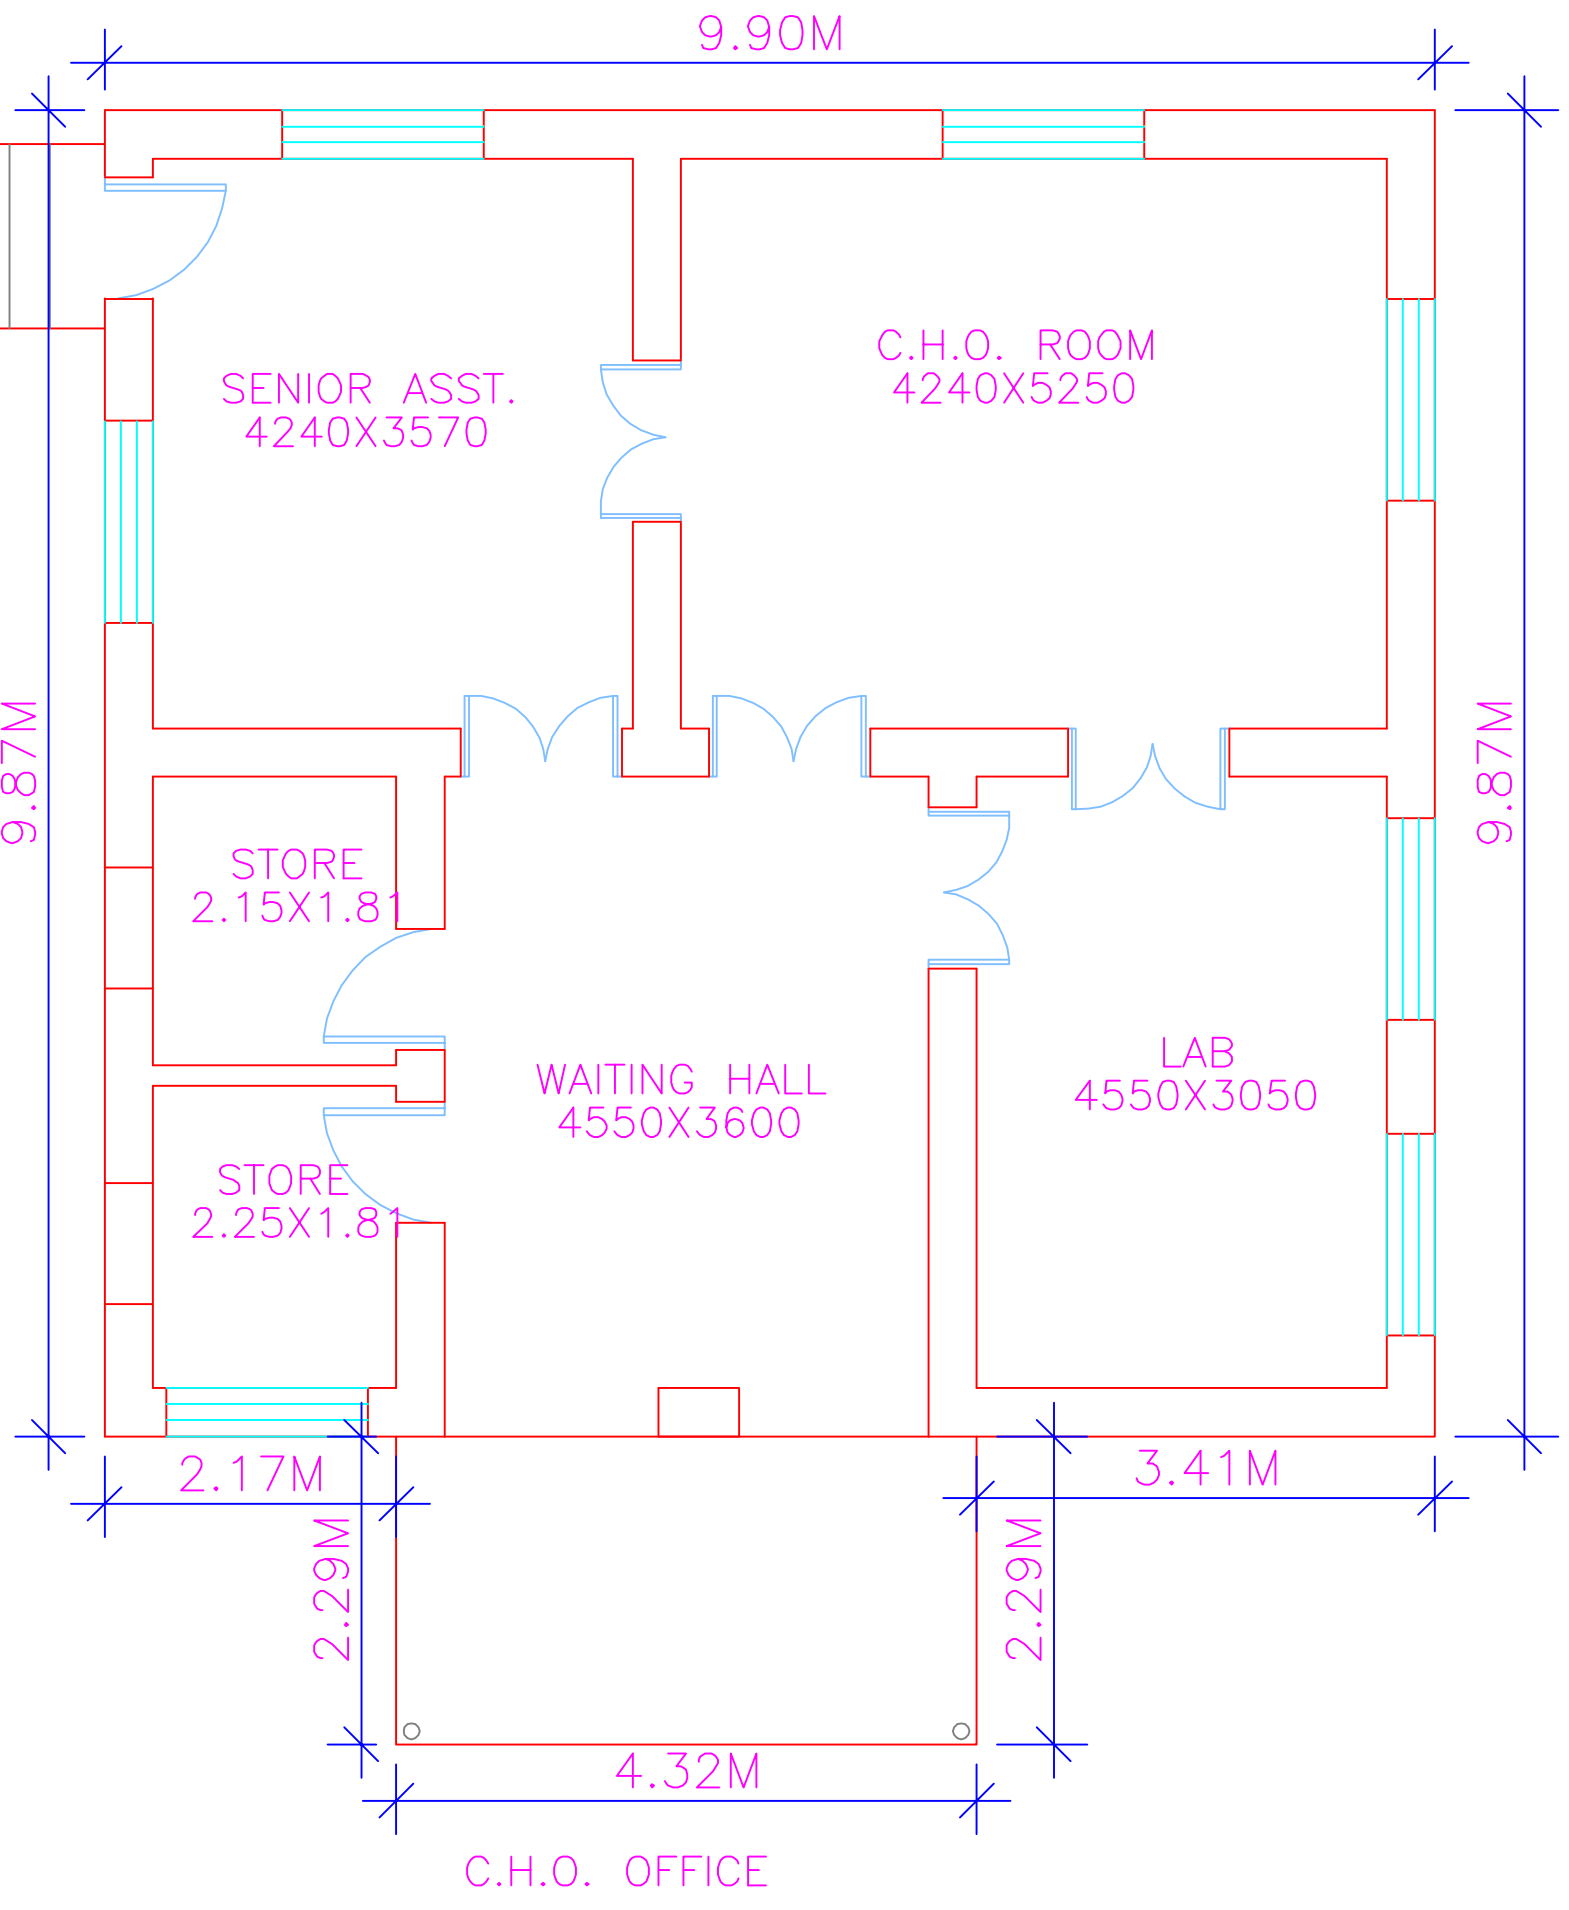

North :

AS BUILT DRAWING

Area:

C.H.O. OFFICE	107.60 SQMTS
TOTAL	107.60 SQMTS

STATUS :

EXISTING BUILDING

PROJECT :

SURVEY PLAN AND ASSET MAPPING FOR HOSPITALS AND MEDICAL COLLEGES IN WARANGAL DISTRICT

TITLE :

PHC-DUGGONDI
FLOOR PLAN

CLIENT :

TELANGANA STATE MEDICAL SERVICES
INFRASTRUCTURE DEVELOPMENT CORPORATION
(An Enterprise of Government of Telangana)
DM & HS CAMPUS
SULTAN BAZAR, KOTI, HYDERABAD.

CONSULTANTS :

ARCHITECTS
INTERIOR
DESIGNERS
375, Road No.10, Jubilee Hills,
Hyderabad-500034.
Ph: 04023553510
e-mail: office@mkteam.in

DATE :	15-07-2016	SHEET NO:
SCALE :	N.T.S.	04
DEALT BY :	B.PAVAN	
SURVEYOR :	B.V.RAMANA	
CHECKED BY :	K.MURALI	

DRG.NO:- MKT / TSMSIDC /DUGGONDI/ CHO OFFICE/ AD-04