NAME OF THE WORK

SURVEY PLAN AND ASSET MAPPING FOR HOSPITALS AND MEDICAL COLLEGES IN THE STATE OF TELANGANA

PRIMARY HEALTH CENTRE AT SIDDAPUR, WARANGAL DISTRICT

CLIENT:

TSMSIDC, 2nd floor, DM & HS Campus,
Sultan Bazar, Koti, Hyderabad-500095.

CONSULTANTS:

MK Team
ARCHITECTS
INTERIOR
DESIGNERS

375, Road No.10, Jubilee Hills,
Hyderabad -500034, A.P., India
Ph: 04023553510
e-mail: mkteam1233@gmail.com

PRIMARY HEALTH CENTRE AT SIDDAPUR
WARANGAL DISTRICT

EXTENT OF AREA	:	**3368.027 SQ.YDS (OR) 0.69 ACRES**
BUILT-UP AREA	:	
HOSPITAL MAIN BLOCK	:	**317.25 SQ.MT (OR) 3414.879SFT**
TYPE OF BUILDING	:	
HOSPITAL MAIN BLOCK	:	**RCC FRAMED STRUCTURE**
NO OF FLOORS	:	
HOSPITAL MAIN BLOCK	:	**GROUND FLOOR**

Executive Engineer
T.S.M.S.I.D.C. Division,
Warangal.

PRIMARY HEALTH CENTRE AT SIDDAPUR

FRONT VIEW

CORRIDOR

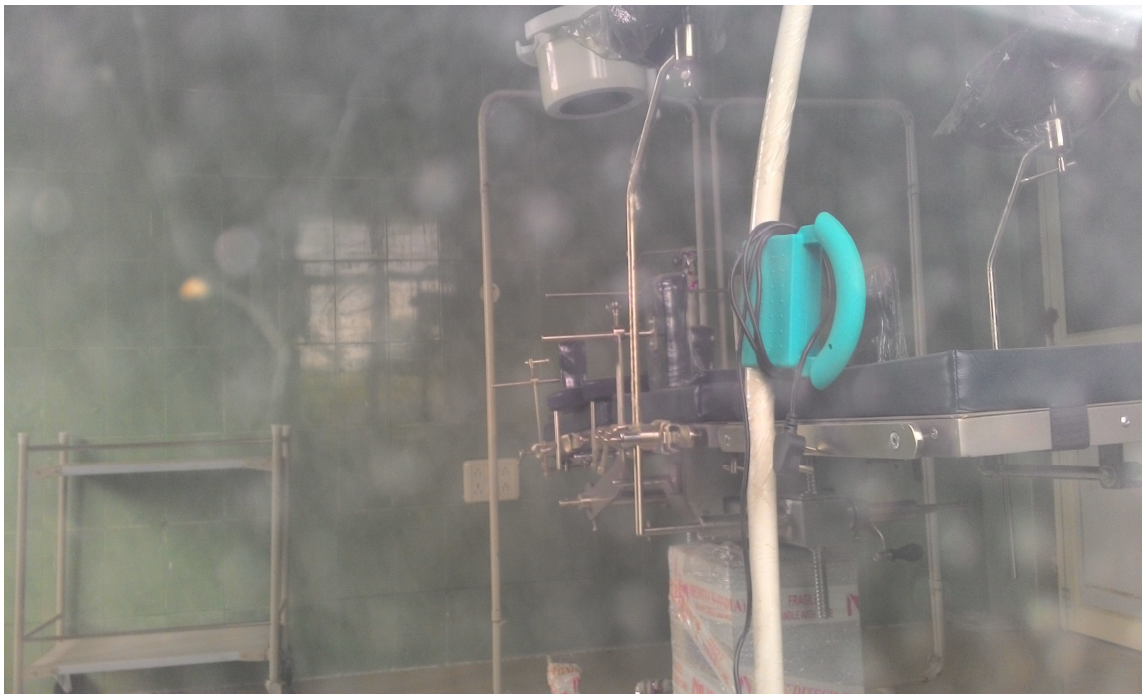

MEDICINE STORE ROOM

WARD

LAB

MEDICAL OFFICER ROOM

COPY RIGHT OF THIS DRAWING BELONGS TO M/S MK. TEAM AND SHOULD NOT BE USED FOR ANY PURPOSE OTHER THAN SPECIFIED WITHOUT PRIOR PERMISSION.

North :

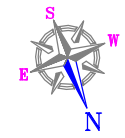

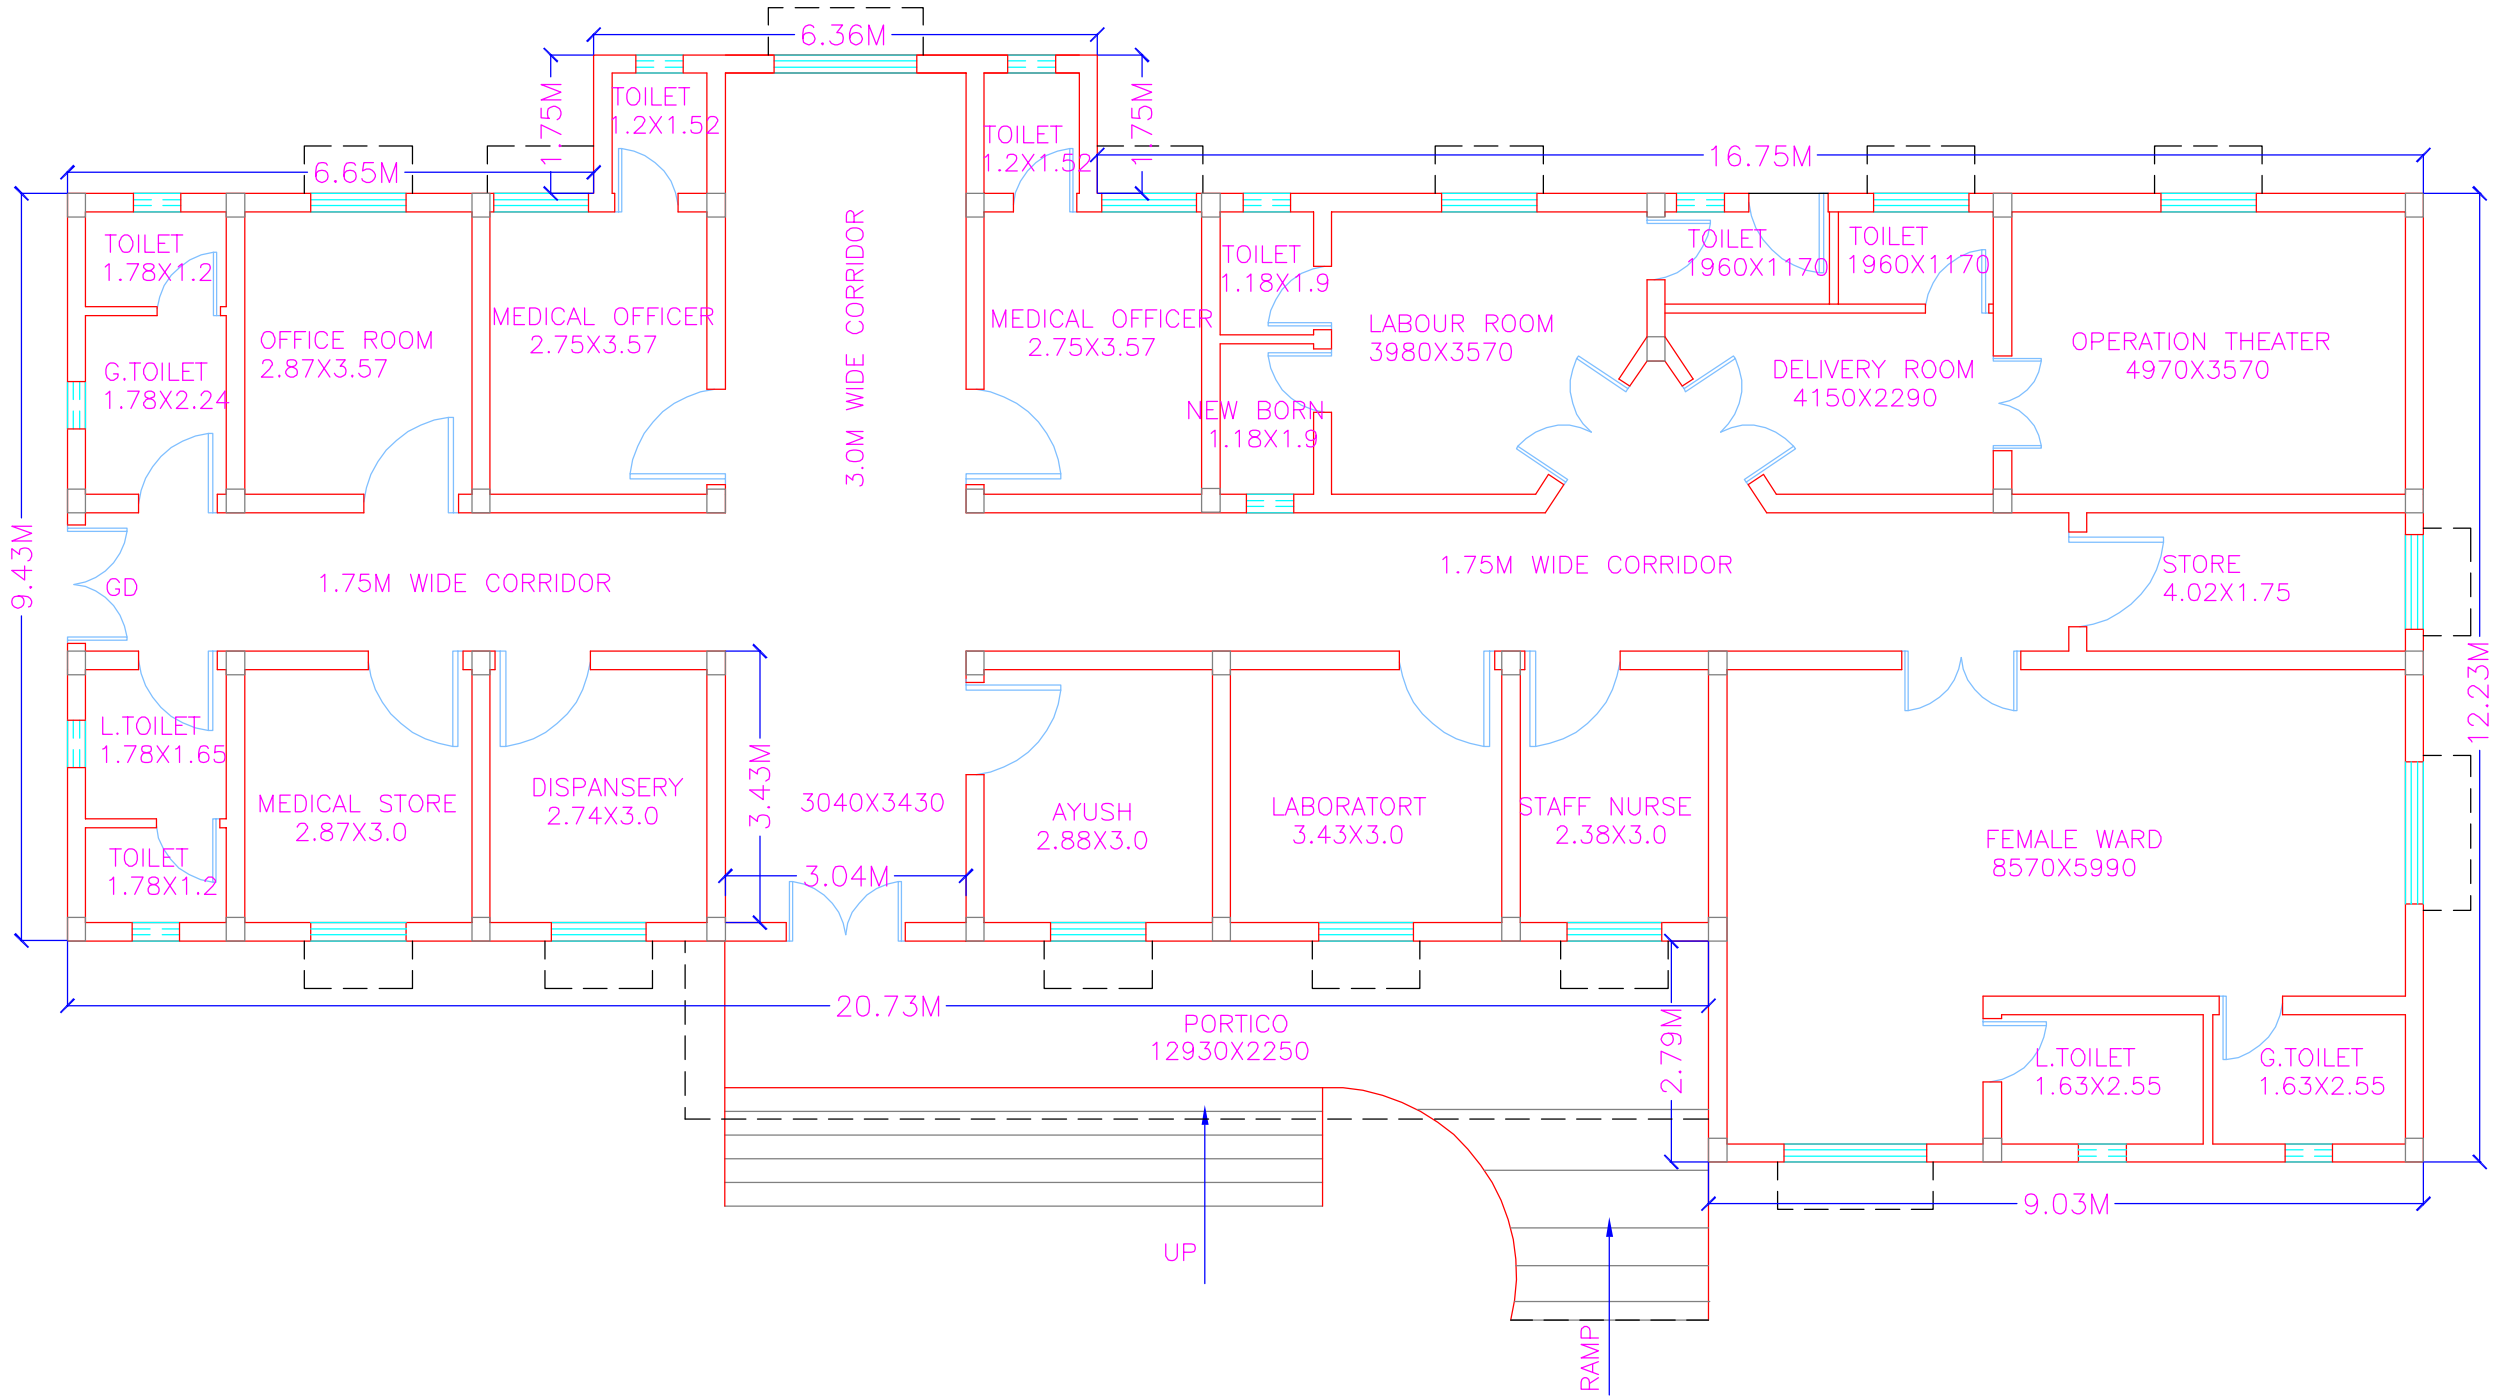

Executive Engineer
T.S.M.S.I.D.C. Division,
Warangal.

AS BUILT DRAWING

AREA:	
GROUND FLOOR	317.25 SQMTS
TOTAL	317.25 SQMTS

STATUS :

EXISTING BUILDING

PROJECT :

SURVEY PLAN AND ASSET MAPPING FOR HOSPITALS AND MEDICAL COLLEGES IN WARANGAL DISTRICT

TITLE :

PHC-SIDDAPUR
FLOOR PLAN

CLIENT :

TELANGANA STATE MEDICAL SERVICES
INFRASTRUCTURE DEVELOPMENT CORPORATION
(An Enterprise of Government of Telangana)
DM & HS CAMPUS
SULTAN BAZAR, KOTI, HYDERABAD.

CONSULTANTS :

mk team
ARCHITECTS
INTERIOR
DESIGNERS
375, Road No.10, Jubilee Hills,
Hyderabad-500034.
Ph: 04023553510
e-mail: office@mkteam.in

DATE :	15-08-2016	SHEET NO:
SCALE :	N.T.S.	03
DEALT BY :	PRUDHVI	
SURVEYOR :	B.V.RAMANA	
CHECKED BY :	K.MURALI	

DRG.NO:- MK / TSMSIDC /SIDDAPUR/ GROUND FLOOR / AD-03

COPY RIGHT OF THIS DRAWING BELONGS TO M/S. M.K.TEAM
AND SHOULD NOT BE USED FOR ANY PURPOSE OTHER THAN SPECIFIED
WITHOUT PRIOR PERMISSION.

North :

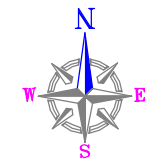

Legend :

TREE
BORE
MANHOLE
ELECTRICAL POLE
EXISTING ROAD
STATION POINT

Legend

S.NO	NAME OF BLOCK	GROUND FLOOR AREA IN SQ.MTS
1.	HOSPITAL MAIN BLOCK	317.25

AREAS :

2816.10 SQ.MTS
3368.027 SQ.YRD
0.69 Acres

PROJECT :

SURVEY PLAN AND ASSET MAPPING
FOR HOSPITALS AND MEDICAL COLLEGES
IN WARANGAL DISTRICT

TITLE :

PHC-SIDDAPUR
SURVEYED SITE LAY-OUT

CLIENT :

TELANGANA STATE MEDICAL SERVICES
INFRASTRUCTURE DEVELOPMENT CORPORATION
(An Enterprise of Government of Telangana)
DM & HS CAMPUS
SULTAN BAZAR, KOTI, HYDERABAD.

CONSULTANTS :

MK team
ARCHITECTS
INTERIOR
DESIGNERS
375, Road No.10, Jubilee Hills,
Hyderabad-500034.
Ph: 04023553510
e-mail: office@mkteam.in

DATE :	16-08-2016	SHEET NO:
SCALE :	N.T.S.	01
DEALT BY :	TARA KRISHNA	
SURVEYOR :	B.V.RAMANA	
CHECKED BY :	K.MURALI	

DRG.NO:- MK / TSMSIDC / SIDDAPUR /
SURVEYED SITE LAY-OUT / AD-01

Executive Engineer
T.S.M.S.I.D.C. Division,
Warangal.

COPY RIGHT OF THIS DRAWING BELONGS TO M/S. M.K.TEAM
AND SHOULD NOT BE USED FOR ANY PURPOSE OTHER THAN SPECIFIED
WITHOUT PRIOR PERMISSION.

North :

N
W E
S

Legend :

TREE
BORE
MANHOLE
ELECTRICAL POLE
EXISTING ROAD
STATION POINT

Legend

S.NO.	NAME OF BLOCK	GROUND FLOOR AREA IN SQ.MTS
1.	HOSPITAL MAIN BLOCK	317.25

AREAS :

2816.10 SQ.MTS
3368.027 SQ.YRD
0.69 Acres

PROJECT :

SURVEY PLAN AND ASSET MAPPING
FOR HOSPITALS AND MEDICAL COLLEGES
IN WARANGAL DISTRICT

TITLE :

PHC-SIDDAPUR
SURVEYED SITE LAY-OUT

CLIENT :

TELANGANA STATE MEDICAL SERVICES
INFRASTRUCTURE DEVELOPMENT CORPORATION
(An Enterprise of Government of Telangana)
DM & HS CAMPUS
SULTAN BAZAR, KOTI, HYDERABAD.

CONSULTANTS :

mk team
ARCHITECTS
INTERIOR
DESIGNERS
375, Road No.10, Jubilee Hills,
Hyderabad-500034.
Ph: 04023553510
e-mail: office@mkteam.in

DATE :	16-08-2016	SHEET NO:
SCALE :	N.T.S.	02
DEALT BY :	TARA KRISHNA	
SURVEYOR :	B.V.RAMANA	
CHECKED BY :	K.MURALI	

DRG.NO:- MK / TSMSIDC / SIDDAPUR /
SURVEYED SITE LAY-OUT / AD-02

Executive Engineer
T.S.M.S.I.D.C. Division,
Warangal.